

## NOV 3 0 2015 Change Record

Contract Number	Contra	ct Title	Federal Aid Number
8715	Kee	chelus Dam to Stampede Pass Phase 2A	State Project
Change Order Number	Chang	e Description	Date
7	VEC	P No. 1 Staging Revision	Nov 20, 2015
Region		Project Engineer	Phone Number
South Central Region		Scott Golbek	509-577-1810
Prime Contractor / Design-Build	der		
Guy F. Atkinson Constru	ction		
Ordered by Engineer ur	der the	terms of Section 1-04.4 of the Standard Specificati	ons or the RFP
Change proposed by C	ontracto	r / Design-Builder	

#### **Evolution & Description Of Change**

#### **Change Evolution:**

On April 30, 2015 discussions began between Atkinson Construction and the Project Engineer Scott Golbek regarding a VECP to reduce the construction staging from five stages to two.

The ability to reduce the construction staging is made possible as Atkinson Construction is also the Prime Contractor for Contract 8127. Given this, the Contractor is much more able to coordinate and reduce conflict between the two projects. Scott Golbek worked with South Central Region Construction, Brian White and Will Smith as well as Mike Fleming of Headquarters Construction on the feasibility of the proposal and other requirements needed to implement the proposal. The Contractor's proposal will realign the westerly end of the DE1 lane to parallel the existing eastbound traffic. This will expose the entire west bound limits of the project for construction in a single phase. This effectively eliminates phases three through five as outlined in the Special Provisions, Section 1-08.4, Order of Work.

Atkinson Construction provided the necessary documentation for Concept Approval which was granted by Scott Golbek on June 11, 2015.

Approval to proceed without a change order was granted by Scott Golbek on June 26, 2015.

Headquarters' concurrence by Mike Fleming on September 17, 2015

South Central Region Construction concurrence by Will Smith on September 17, 2015

#### **Description of Change:**

This change order will incorporate a Value Engineering Change Proposal into the Contract as outlined in Section 1-04.4(2). This Contract is a multiple year project with five distinct construction phases as outlined in the Special Provisions in Section 1-08.4. These phases are required to avoid conflict with another large construction project, C8127; I-90 / Snowshed to Keechelus Dam Phase 1C – Replace Snowshed and Add Lanes, and the need to maintain two lanes of traffic in both the east and westbound directions of travel. This phasing reduces conflict due to construction activities at the westerly project limits of this Contract

The Contract Provisions, Section 1-04.4(2), provides a means for the Contractor to propose a Value Engineering Change Proposal, (VECP), to the Contract that will provide either a savings to WSDOT or reduce the time required to construct the project. The Contractors proposal will provide both a savings to the State by reducing the number of construction stages and will reduce the overall Contract duration.

The primary result of this change order will be to reduce the number of construction stages from five to two, and reduce construction time by approximately one year, completing the project in October 2018.

The cost savings from this VECP are primarily gained from the elimination of Stages 3 through 5 and the associated work. This cost is outlined in the Price section of this Memorandum.

This change order as executed will accomplish the following:

- Provide plans to realign the westerly end of the DE1 line which will provide access for the Contractor to work on the entire westbound alignment.
- Reduce the number of construction stages from 5 to 2.
- Reduced quantities will be realized due to the reduced staging.
- Overall cost savings to the Contract that will be shared between Atkinson Construction and WSDOT.

Contract Number	Contract Title	Change Order Number
8715	Keechelus Dam to Stampede Pass Phase 2A	7

#### Basis of Cost & Justification:

As outlined in Section 1-04.4(2)B, both the Contracting Agency and the Contractor are entitled to share equally in the savings generated by a VECP. Entitlement is found to provide for an equitable adjustment to the Contractor for the reduced quantity of HMA related to this VECP. The HMA is reduced by 5,900 tons which excludes the subcontractor in this case from recovering fixed overhead costs distributed across the entire bid amount. Although the reduction does not exceed 25% as described in Section 1-04.6 the subcontractor through no action of their own are being penalized and is entitled to compensation. The monetary savings generated by this VECP are realized by the elimination of associated Contract Work from Phases 3 through 5. Many bid items are affected with the net changes included in the Change Order. The overall cost savings as determined by Section 1-04.4(2)B is as follows:

 Deleted Work
 \$-1,622,010.16

 Added Work
 \$37,000.00

 Contractor Incentive
 \$734,369.64

 Contractor Engineering
 \$111,611.87

 Miscellaneous Items
 \$40,550.00

<u>Survey</u> \$15,000,00 Total -\$683,418.65

#### **Gross Savings:**

(gross cost of deleted work) – (gross cost of added work) = \$1,582,750.16

#### Net savings:

(gross savings) – (contractor's engineering costs) – (WSDOT costs Eng \$2,399.00) = \$1,468,739.29 (/2 =\$734,369.64 Contractor incentive amount) The net cost of this change order results in a savings to WSDOT in the amount of \$683,418.65.

#### Contract Time:

#### **Contract Time:**

Contract time will be reduced by 15 days. Although it is the Contractor's goal to complete the project by October 15, 2018, nearly a year ahead of schedule, the expected savings in working days is not realized immediately as the Contractor is committed to working late into the fall and earlier in the spring. This added effort on the Contractors part was not considered in the schedule developed in the WSDOT design effort. In comparing the proposed accelerated schedule with the base schedule, 15 working days are saved.

#### Prior Approvals:

Concept Approval by Scott Golbek on June 11, 2015.

Approval to proceed without a change order by Scott Golbek on June 26, 2015.

Final Approval by Will Smith, SCR Region Construction Manager on September 17, 2015.

Final Approval by Mike Fleming, Headquarters Construction on September 17, 2015.

	ents:

Distribution: Copy of Change Record & Change Order w/Backup - Project Engineer Copy of ONLY Change Order - Prime Contractor / Design-Builder

Copy of Change Record & Change Order w/Backup - Region Construction Office

Electronic Copy & Original of Change Record & Change Order w/Backup - State Construction Office

**DATE:** 11/02/15 Page 1 of 43

CONTRACT TITLE: I-90, X

**FEDERAL AID NO:** 

I-90, KEECHELUS DAM TO STAMPEDE PASS PHASE 2A- ADD

CHANGE ORDER NO: 7 VECP NO. 1 STAGING REVISION

PRIME CONTRACTOR:		N CONSTRUCTION, LLC. Y WAY SUITE 500	
	RENION	WA 98057-3	3224
( ) Ordered by Engineer under the term $(X)$ Change proposed by Contractor	ns of Section 1-04.4 of the	Standard Specifications	
ENDORSED BY:	E PRESIDENT	SURETY CONSENT:	
CONTRACTOR	Z Magnison	ATTORNEY IN FACT	,
DATE		DATE	WSDOT
ORIGINAL CONTRACT AMOUNT: CURRENT CONTRACT AMOUNT: ESTIMATED NET CHANGE THIS ORDER ESTIMATED CONTRACT TOTAL AFTER ( Approval Required: ( ) Region	72,8 : -6 CHANGE: 72,1 ( ) Olympia Se		
DATE DATE	TALS 2	1	CCIS ENTRY DATE 11/23/, ENTERED BY
PROJECT ENGINEER  11/20/15 DATE	( ) EXECUTED	STATE CONSTRUCTION ENG	INEER
(X) APPROVAL RECOMMENDED	( ) EXECUTED	OTHER APPROVAL WHEN RE	QUIRED
BY: W  All 23/15  DATE	8. Brian White	SIGNATURE	DATE

DATE: 11/02/15
Page 2 of 43

CONTRACT NO: 008715

CHANGE ORDER NO:

7

All work, materials, and measurements to be in accordance with the provisions of the Standard Specifications and Special Provisions for the type of construction involved.

This contract is revised as follows:

#### Description:

This change order incorporates a Value Engineering Change Proposal (VECP) in accordance with Section 1-04.2(2) into the Contract. Work will consist of a realignment of the DE1 Line, involving grading, surfacing and HMA paving. Revisions to the Order of Work as outlined in the Special Provisions are also made as part of this change order.

This VECP as proposed will reduce the construction stages from five to two. Work currently shown in the Plans as Stages 3 through 5 shall be incorporated into either of the two stages proposed by the Contractor.

By endorsing this Change Order Guy F. Atkinson Construction, (the Contractor), agrees to the following:

- 1. The Contractor accepts design risk of all features, both temporary and permanent, of the changed Work.
- 2. The Contractor accepts risk of constructability of the changed Work.
- 3. The Contractor provides the Contracting Agency with the right to use all or any part of the proposal on future projects without further obligation or compensation.
- 4. By endorsing this change order the Contractor agrees that any costs incurred, caused solely as a result of this VECP, by the Contractor for additional overhead, impacts to Work, or any other added costs associated with completing Contract Work beyond the 2018 construction season, shall be solely at the Contractors expense.

The Special Provision, Construction Timing for Rock Cuts from LW 1440+41 to LW 1457+41, page 135, lines 40 to 42, is deleted.

Section 1-08.4 of the Special Provisions, Order of Work, Page 136, Line 47 through Page 139 Line 18, is deleted.

Changes to the Approved Project Schedule shall be addressed with the next submitted schedule update as outlined in the Special Provision, Schedule Updates.

The following items are added to the Contract:

- C.O. 7; VECP No. 1 Contractor Incentive
- C.O. 7; VECP No. 1 Contractor Engineering
- C.O. 7; VECP No. 1, Miscellaneous Items
- C.O. 7; VECP No. 1, Survey

DATE: 11/02/15
Page 3 of 43

CONTRACT NO: 008715 CHANGE ORDER NO: 7

The following items are deleted from the Contract:

Item 164; Transportable Attenuator

Item 165; Operation of Transportable Attenuator

Item 237; Sequential Arrow Sign

Item 238; Portable Changeable Message Sign

Item 240; Flaggers

Item 241; Other Temporary Traffic Control

The following Plan Sheets are Deleted, Revised or are Added:

Deleted Sheet	Revised Plan Sheet 35/TR1-1	Added Plan Sheet	
	36/TR1-2	TRLA-1	
	46/QS1-1	II.CA-I	
	47/QS1-2		
	48/QS1-3		
	49/QS1-4		
		QS1A-1	
D4 4		QS1A-2	
D1-1 D1-2		D1A-1 D1A-2	
D1-2 D1-3		D1A-2 D1A-3	
D1-2		TRIB-1	
		QS1B-1	
		QS1B-2	
		D1B-1	
68/TR2-1		TR2A-1	
69/TR2-2		TR2A-2	
		TR2A-3	
	70 /mpg 2	TR2A-4	
	70/TR2-3 74/QS2-1		
	75/QS2-1 75/QS2-2		
	73/ 002 2	QS2A-1	
		QS2A-2	
		D2A-1	
76/D2-1		D2A-2	
77/D2-2		D2A-3	
78/D2-3		D2A-4	
79/D2-4		D2A-5	
80/D2-5		D2A-6	
	86/TPS2-1	TPS2-1	
88/TR3-1		IFDZ-I	
89/TR3-2			
32/2102	91/QS3-1		
	-, <b>-</b>	QS3B-1	
=		QS3B-2	 

DATE: 11/02/15
Page 4 of 43

**CONTRACT NO: 008715** 

**CHANGE ORDER NO:** 

92/D3-1

93/D3-2

· D3B-1

Unless included in the list above Plan Sheets 87 to 118 are deleted from the Contract.

#### Construction Requirements:

The Contractor shall construct the Work as detailed on the Contractor provided Plan Sheets as shown on pages 6 through 42 of this change order.

The Contractor shall provide all surveying relating to this change order as described in the Special Provision, Contractor Surveying Roadway.

Saw cutting of existing pavement will be required for removal of detour crossovers.

The Contractor shall provide all traffic control needs for the Work in accordance with Section 1-10 at no additional cost to the Contracting Agency. Traffic control costs associated with work added by future change orders will be addressed at that time.

#### Measurement:

- C.O. 7; VECP No. 1 Contractor Incentive; no specific unit of measurement will apply.
- C.O. 7; VECP No. 1 Contractor Engineering; no specific unit of measurement will apply.
- C.O. 7; VECP No. 1, Miscellaneous Items; no specific unit of measurement will apply.
- C.O. 7; VECP No. 1, Survey; measurement will be made in accordance with Section 1-09.6.

#### Payment:

"C.O. 7; VECP No. 1 Contractor Incentive", lump sum. The lump sum payment will be based on the following calculations:

#### Proposal Savings:

Gross Savings = (gross cost of deleted work) minus (gross cost of added work)
Gross Savings = \$1,582,750.16

Gross cost of deleted work = \$1,622,010.16 Gross cost of added work = \$39,260.00

Net Savings = (gross savings) minus (contractor's engineering costs) minus (WSDOT costs)
Net Savings = \$1,468,739.29

Contractor's Engineering costs, (not including Survey) = \$111,611.87

DATE: 11/02/15 Page 5 of ዛ3

**CONTRACT NO: 008715** 

CHANGE ORDER NO:

7

WSDOT Engineering costs = \$2,399.00

Contractor's Incentive payment = (net savings) / 2 Contractor's Incentive payment = \$734,369.64

- "C.O. 7; VECP No. 1 Contractor Engineering", lump sum. Contractor engineering costs will be determined from invoices provided by the Contractor for engineering services relating to VECP No. 1.
- "C.O. 7; VECP No. 1, Miscellaneous Items", lump sum. The lump sum payment will be considered full payment for incidental items associated with VECP No. 1; limited to the following item:
  - Saw cutting
  - An equitable adjustment of \$38,350 is made to compensate for lost overhead and profit as a result of the reduced quantity of HMA.
- "C.O. 7; VECP No. 1, Survey", force account. Payment will be made in accordance with Section 1-09.6.

Contract Time:

Fifteen working days are deleted from the Contract.

DATE: 11/02/15
Page 6 of 43

CON	CONTRACT NO: 008715		CHANGE ORDER NO: 7					
ITEM NO	GROUP NO			UNIT MEASURE	UNIT PRICE	EST QTY CHANGE	EST AMT CHANGE	
0013	01	0170	REMOVING GUARDRAIL	L.F.	2.80	-928.00	-2,598.40	
0015	01	0330	ROADWAY EXCAVATION INCL. HAUL - AREA A	C.Y.	6.00	-8,170.00	-49,020.00	
0020	01	0332	PAVEMENT REPAIR EXCAVATION INCL. HAUL	S.Y.	5.50	-440.00	-2,420.00	
0025	01	0470	EMBANKMENT COMPACTION	C.Y.	2.30	-36,360.00	-83,628.00	
0047	01	1161	UNDERDRAIN PIPE 8 IN. DIAM.	L.F.	17.00	410.00	6,970.00	
0053	01	1182	SCHEDULE A CULV. PIPE 18 IN. DIAM.	L.F.	45.00	-6.00	-270.00	
0059	01		TEMPORARY STAND PIPE	EACH	425.00	2.00	850.00	
0099	01	5100	CRUSHED SURFACING BASE COURSE	TON	15.00	-10,890.00	-163,350.00	
0108	01	5766	HMA CL. 3/8 IN. PG 64-28	TON	73.00	-5,900.00	-430,700.00	
0110	01	5830	JOB MIX COMPLIANCE PRICE ADJUSTMENT	CALC	125,777.00	0.00	-12,106.00	
0111	01	5835	COMPACTION PRICE ADJUSTMENT	CALC	83,850.00	0.00	-8,070.00	
0116	01	6463	CHECK DAM	L.F.	11.00	-108.00	-1,188.00	
0117	01	6471	INLET PROTECTION	EACH	80.00	-48.00	-3,840.00	
0120	01	6500	COMPOST SOCK	L.F.	6.00	-2,640.00	-15,840.00	
0121	01	6490	EROSION/WATER POLLUTION CONTROL	EST.	2,000,000.00	0.00	-400,000.00	
0122	01	6457	MULCHING WITH LONG TERM MULCH	ACRE	2,700.00	-40.00	-108,000.00	
0125	01	6630	HIGH VISIBILITY FENCE	L.F.	2.00	-12,620.00	-25,240.00	
0126	01	6635	HIGH VISIBILITY SILT FENCE	L.F.	5.00	-3,290.00	-16,450.00	
0147	01	6711	BEAM GUARDRAIL TYPE 31 - 8 FT. LONG POST	L.F.	28.00	-928.00	-25,984.00	
0153	01	6760	BEAM GUARDRAIL TRANSITION SECTION TYPE 21	EACH	3,800.00	-1.00	-3,800.00	
0155	01	6766	BEAM GUARDRAIL ANCHOR TYPE 10	EACH	1,100.00	1.00	1,100.00	
0156	01		BARRIER GAP	EACH	1,050.00	14.00	14,700.00	
0161	01	6781	TEMPORARY CONC. BARRIER	L.F.	9.00	-17,542.50	-157,882.50	
0163	01	7445	RESETTING IMPACT ATTENUATOR	EACH	875.00	-4.00	-3,500.00	
0164	01	7447	TRANSPORTABLE ATTENUATOR	EACH	0.01	-6.00	-0.06	
0165	01	7449	OPERATION OF TRANSPORTABLE ATTENUATOR	HOUR	0.01	-16,480.00	-164.80	
0168	01	7445	TEMPORARY RIGID GUIDE POST	EACH	50.00	-66.00	-3,300.00	
0169	01		LDS BARRIER DELINEATOR	EACH	34.00	-524.00	-17,816.00	
0171	01		SNOW POLE	EACH	22.00	-483.00	-10,626.00	
0171	01	6896	TEMPORARY PAVEMENT MARKING-LONG DURATION	L.F.	0.40	-162,722.00	-65,088.80	
0237	01	6956	SEQUENTIAL ARROW SIGN	HOUR	0.01	-16,480.00	-164.80	
	01	6993	PORTABLE CHANGEABLE MESSAGE SIGN	HOUR	0.01	-28,240.00	-282.40	
0238	01	6980	FIAGGERS	HOUR	0.01	-8,240.00	-82.40	
0240	01	6992	OTHER TRAFFIC CONTROL LABOR	HOUR	0.01	-49,400.00	-494.00	
0241		0332		L.F.		-	-10,104.00	
	01	7014	TEMPORARY GLARE SCREEN		8.00	-1,263.00	•	
0249 1 <b>90</b> 6	01	7014	GRAVEL BACKFILL FOR DRAIN	C.Y.	42.00	320.00	13,440.00	
	01		C.O. 7; VECP NO. 1, CONTRACTOR INCENTIVE	L.S.	0.00	0.00	734,369.64	
1907	01		C.O. 7; VECP NO. 1, CONTRACTOR ENGINEERIN	L.S.	0.00	0.00	111,611.87	
1968	01		C.O. 7; VECP NO. 1, MISCELLANEOUS ITEMS	L.S.	0.00	0.00	40,550.00	
1009	01		C.O. 7; VECP NO. 1, SURVEY	EST.	0.00	0.00	15,000.00	

-683,418.65

-----

#### CHANGE ORDER-CHECKLIST

Cont. #: 8715 Cont. Title: Keechels Pon To Stampede R. C.O. #: 7 C.O. Title: VECP Ho. 1 Staging Roussian	ass -	AS.	If yes, State Construction Office Approval Required.
I. Executed by the State Construction Office			
1. Cost or credit equal to or exceeding \$200,000.*1	Yes	□No	X
<ol> <li>Change in the contract documents beyond the scope, intent or termini of the original contract.*2</li> </ol>	☐ Yes	<b>⊠</b> No	X
Any proposed revision or deletion of work that affects the condition of award requirements.  (Must be coded "CO" in CCIS)	☐ Yes	No No	X
<ol> <li>Change in contract time greater than 30 working days, or a change in contract time not related to any change order.</li> </ol>	☐ Yes	No	×
II. Executed by the Region		1	
5. Cost or credit greater than \$100,000 but less than \$200,000. '1	☐ Yes	No	
<ol><li>Change in contract time greater than 10 and less than or equal to 30 working days (must be related to changes implemented by change order).</li></ol>	☐ Yes	<b>™</b> No	
III. Executed by the Project Engineer	-		
7. Determination of impacts and/or overhead.	☐ Yes	Ø No	×
<ol> <li>Specification change involving Headquarters generated specification. (Includes Region generated specification requiring State Construction Office Approval)</li> </ol>	<b>™</b> Yes	□No	х
Specification change involving Region generated specifications.	Yes	□No	
10. Material or product substitution.	Yes	Ø No	X
11. Structural design change in the roadway section. (Requires State Materials Lab approval)	☐ Yes	₫(No	
12. Determination of changed condition.(Section 1-04.7 of the Standard Specifications)	☐ Yes	No	X
13. Selliement of a claim.(Section 1-09.11(2) of the Standard Specifications)	☐ Yes	No	Х
<ol> <li>Repair of damage regarding "acts of God" or "acts of the public enemy or of government authorities". (Section 1-07.13 of the Standard Specification)</li> </ol>	Yes	₩No	х
15. Structural change to structures.(See BTA authority as shown in the Construction Manual)	☐ Yes	₩ No	х
Approvals obtained: Project Engineer (Required):		Date:	6/11/15
Region (Required if yes marked):		Date:	5/17/15
State Construction Office:		Date:	9/11/15
State Materials Lab:		Date:	
Other (Local Agency, FHWA, Surely, etc.):		Date:	
To be completed by the Project Engineer:  CO Reason(s) (See "2008 Codes and Definitions" on HQ Construction SharePoint):	1-04/0	21/1	P/AF
Change Order Prepared By: Kick Holyook		Date:	9/15
Has change been entered as lesson learned?  Yes XNo Has design documentation be	en updated	ქ? □	Yes 🛛 No
Is this project under full FHWA stewardship oversight? *1 Yes 📈 No			
To be completed by the Region :			
Is the change eligible for Federal participation where applicable? Yes Change Order Reviewed by:		Dale:	12/18/15

(see Construction Manual - Chapter 1-2.4C(3), Chapter 1-3.4, and http://www.v/sdot.wa.gov/biz/construction/Stewardship/Stewardship.xls)

2 Per RCW 47.28.050, any change beyond \$7,500 that is beyond the original scope shall go through the competitive bidding process.

This form represents the minimum information required by the State Construction Office. If you wish to supplement this information, you may do so on a separate sheet of paper.

## REQUIRED INFORMATION FOR CHANGE ORDERS IN CCIS

Contract				
C.O. No.:	C.O. Title: _	VECP MO. 1	Staging ROUSIONS	
Order Da		Proposed By:	E- Engineer C - Contractor	B - Roti
Required	d Approval: KHQ Region		Unilateral Change?: Yes No	- 501
PE Stam			is a Minor Change?: Yes 🛚 No	
Commen	its: Contracts proposed	YELP WILL	reduce construction stage	
	trom 5 to 6-3,	Kediced st	ging will reduce qualitic	
	required of Sexeral	17cm/7		
	DUNT: This amount must be entered when unt entered here is WSDOT's actual saving		=	
APPRO	VAL TO PROCEED			
			GO. GOO, GD T	
Approva	al Date:	Estimated Amoun	t: -163,000.00	
Reques	ted By: Region 🛚 PE	Approved By:	MHQ □ Region □ PE	
N   4	e: Concept Approval, le	111/15 5	44 6 14 15	
Narrativ	Bris America	lolis Bo	is white / will Smith	
	Ho construction App	4/11	12 Intes Lieuna	
		1		
Surety	Consent: Yes No If	yes, Surety Date:	A	
What	section of contract changed?:	ABI Sec 1-04	(Decedes Ctd III - T. III - O. III - )	
VIIIdl	section of contract changeur,	105	(Based on Std. Item Table Section)	
Descr	ribe the Detail Change:		(Based on actual item of work)	
Mhal	t created the need or caused the change	2. TP	/D '	
YYIIA	cereated the freed of caused the change		(Primary (*) 2 letter code - 1 only)	
Wha	it is the purpose of the change order?	AF	(Secondary 2 letter codes - may use 2)	
Cl	D		,	
Chang	ge Reasons:			
Ī	PRIMARY CODES (Need)		CONDARY CODES (Purpose)	
AP	ADMIN PROBLEM		ADMIN CHANGE	
BC	*BUDGET CONSTRAINTS	AW CO	ADDED WORK	
CC	*CHANGED CONDITIONS	CR	CONDITION OF AWARD CORRECTION/REPAIR	
CS	*CLAIM SETTLEMENT *DRB DECISION	DO	DELAY COMPENSATION	
DR EE	*CONST ENGR ERROR	DS	DESIGN CHANGE	
EV	'ENVIROMENTAL	DW	DELETED WORK	
	'HAZARDOUS MATERIAL	MO	QUANTITY VARIATION	
HZ	*CRIP	MR	MAT'LS SPEC REVISION	
	*MATERIAL SUBSTITUTION	OC	OMISSION IN CONTRACT PROVISIONS	
MS NS	'NON-SPEC MATERIAL	OP	OMISSION IN THE PLANS	
PI =	*PLAN ERROR-INFO.	OR	OTHER SPEC REVISION	
PM	PLAN ERROR-MISTAKE	RS	REVISED SCOPE	
SC	SPEC CONFLICT/AMBIG	SA	SCHEDULE ADJUSTMENT	
TP	THIRD PARTY REQUEST	SU	DESIGN SURVEY OR BASE MAP ERROR	
UC	'UNANTICIPATED COND	UP	UTILITY PLAN ERRORS	
00	3/((TION /(TED OOM)	WM	WORK METHOD CHANGE	

## **LEGEND**

ROADWAY EXCAVATION INCL. HAUL EMBANKMENT COMPACTION

3 4 CRUSHED SURFACING BASE COURSE

HMA CL. 3/8 IN. PG 64-28

TEMPORARY CONC. BARRIER

#### GENERAL NOTES:

20

ALL DEPTHS SHOWN ARE FINAL COMPACTED DEPTHS. SEE SHEETS D1-1 TO D1-10 FOR BARRIER LOCATIONS. SEE SHEETS D1-1 TO D1-10 FOR VARIABLE WIDTH LOCATIONS.

SEE TRAFFIC SEQUENCING SHEET TS1 FOR TYPICAL CONSTRUCTION.

#### CONSTRUCTION NOTES:

SEE PROFILE AND SUPERELEVATION - STAGE 1 SHEETS FOR ROADWAY CROSS SLOPES.

2 SEE QUANTITY TABULATION SHEETS FOR BARRIER TYPE AND LOCATION.

4 ADDITIONAL WIDENING FOR FUTURE STAGE 2.

LINE AND STATION RANGE	ROADWAY EXCAVATION INCL. HAUL-AREA A (CY)	EMBANKMENT COMPACTION (CY)
DW1 25+84 TO DW1 33+52	160	1,110
DW1 33+52 TO DW1 37+00	SEE PROFILE FOR	QUANTITIES
DW1 37+00 TO DW1 47+00	6,390	70
DW1 47+00 TO DW1 57+00	1,950	220
DW1 57+00 TO DW1 67+00	3,470	110
DW1 67+00 TO DW1 77+00	4,730	710
DW1 77+00 TO DW1 87+00	2,720	60
DW1 87+00 TO DW1 97+00	890	230
DW1 97+00 TO DW1 107+00	380	0
DW1 107+00 TO DW1 117+00	230	0
DW1 117+00 TO DW1 120+26	90	200
DW1 122+97 TO DW1 133+00	SEE PROFILE FOR	QUANTITIES
DW1 122+97 TO DW1 133+00	580	40
DW1 133+00 TO DW1 140+25	230	100

LINE AND STATION RANGE	ROADWAY EXCAVATION INCL. HAUL-AREA A (CY)	EMBANKMENT COMPACTION (CY)
DE1 83+60 TO DE1 93+00	SEE PROFILE FOR	QUANTITIES
DE1 93+00 TO DE1 1 03+00	SEE PROFILE FOR	QUANTITIES
DE1 103+00 TO DE1 106+78	SEE PROFILE FOR	QUANTITIES
DE1 106+78 TO DE1 116+00	80	0
DE1 116+00 TO DE1 127+23	250	50




					<b>I-90</b>	
	KEEC	HELUS	DAM	то	STA	MP
Washington State		- ADD	LANE	S/BU	ILD	WIL
partment of Transportation						


PEDE PASS PHASE ILDLIFE BRIDGES

TEMP. ROADWAY SECTIONS - STAGE 1

TR1-1 SHEET 35 of 788 SHEETS

Plot 1 PLAN REF NO

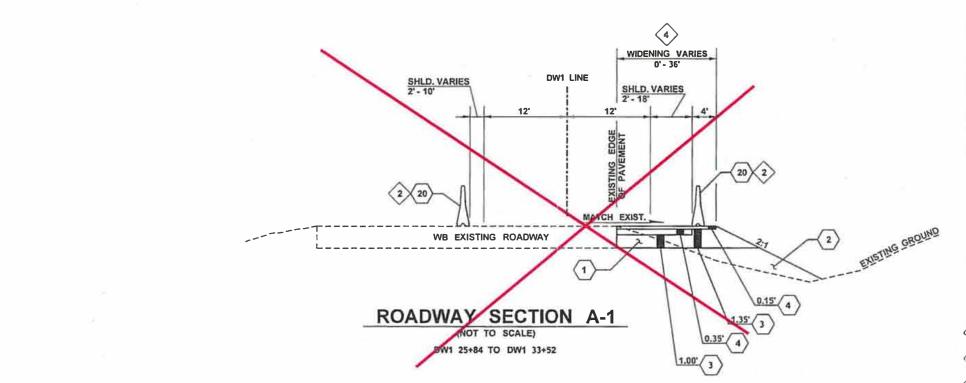

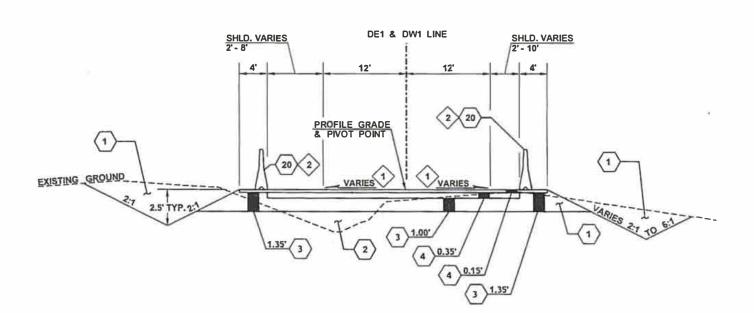


## **ROADWAY SECTION B-1**

(NOT TO SCALE)


DWI 33432 TO DWI 97+ DE1 84+36 TO DE1 104+75 DW1 120+26 TO DW1 121+03

FILE NAME	K:\452201\XL4134_2A\CAD\ContractPlan	ns_Alt\070-StagingPlan\XL4134_PS_SU	TRS_Stage1.dgn				
TIME	11:21:46 AM				REGION NO.	STATE	FED.AID PROJ.NO.
DATE	1/20/2015					TAVA CL	
PLOTTED BY	robersj				10	WASH	
DESIGNED BY	S. ROBERT				12 (427) (45	UMBER	
ENTERED BY	B. CUILLIER			1	14Y	015	
CHECKED BY	P. COOPER			14	CONTR	ACT NO.	LOCATION NO.
PROJ. ENGR.	J. HEILMAN-SUAREZ				i		
REGIONAL ADM.	D WHITEHOUSE	REVISION	DATE	BV		- 1	

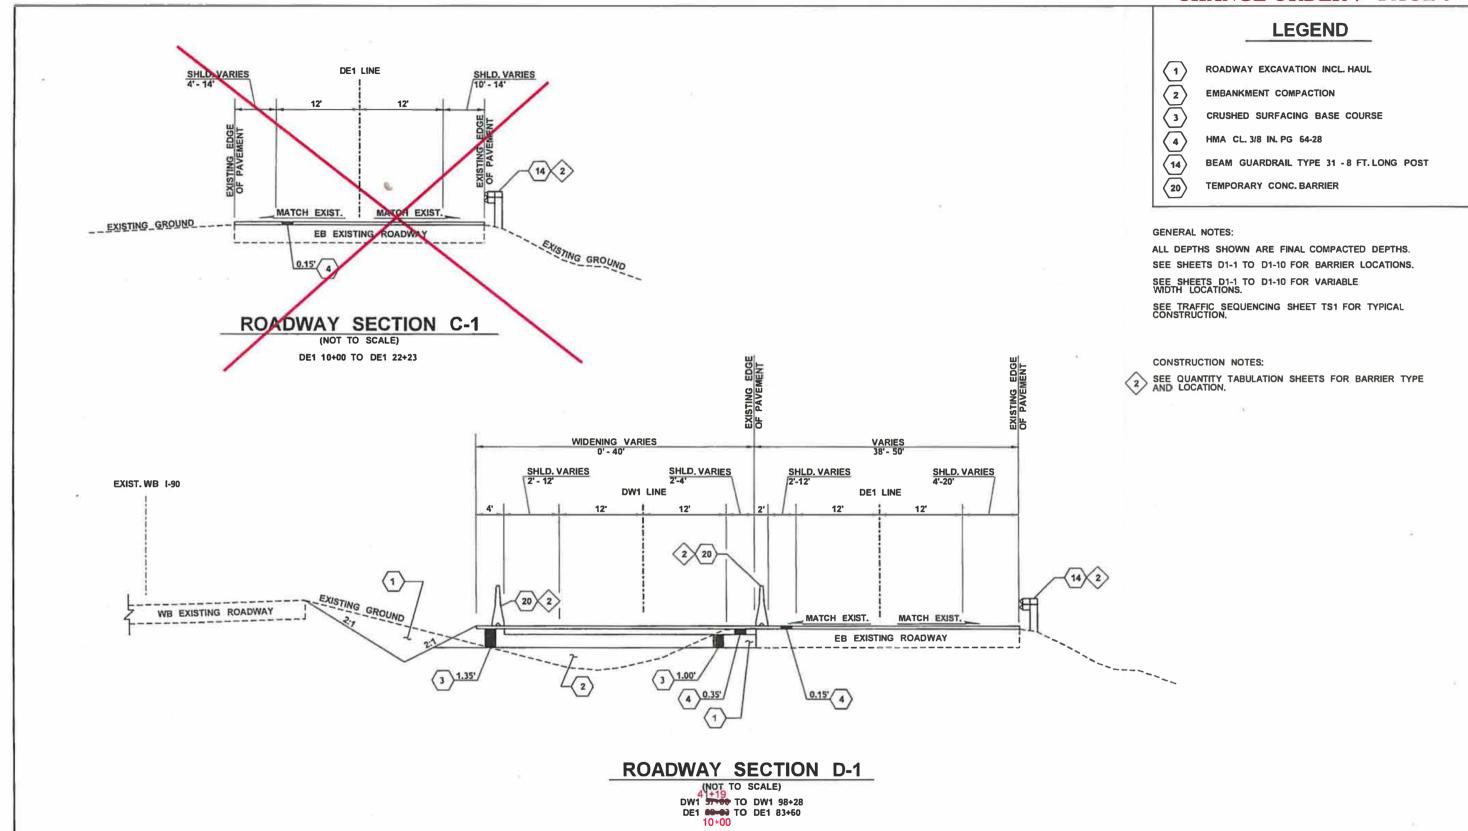

FILE NAME	K:\452201\XL4134_2A\CAD\Contract	Plans Alt\070-StagingPlan\XL4134 PS SU 1	TRS_Stage1.dgn				
TIME	11:21:46 AM				REGION NO.	STATE	FED.AID PROJ.NO.
DATE	1/20/2015				277.9		
PLOTTED BY	robersj				10	WASH	
DESIGNED BY	S. ROBERT			İ		UMBER	
ENTERED BY	B. CUILLIER				14Y	015	
CHECKED BY	P. COOPER			1	CONTR	ACT NO.	LOCATION NO.
PROJ. ENGR.	J. HEILMAN-SUAREZ				1		
REGIONAL ADM.	D. WHITEHOUSE	REVISION	DATE	BY	i .		



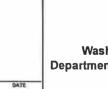


P.E. STAMP BOX

7	ĸ
Washington State	
repartment of fransportation	1

1-90
KEECHELUS DAM TO STAMPEDE PASS PHASE
2A - ADD LANES/BUILD WILDLIFE BRIDGES
TEMP. ROADWAY SECTIONS - STAGE 1

Plot 2
PLAN REF NO
TR1-2

SHEET 36 OF 788 SHEETS

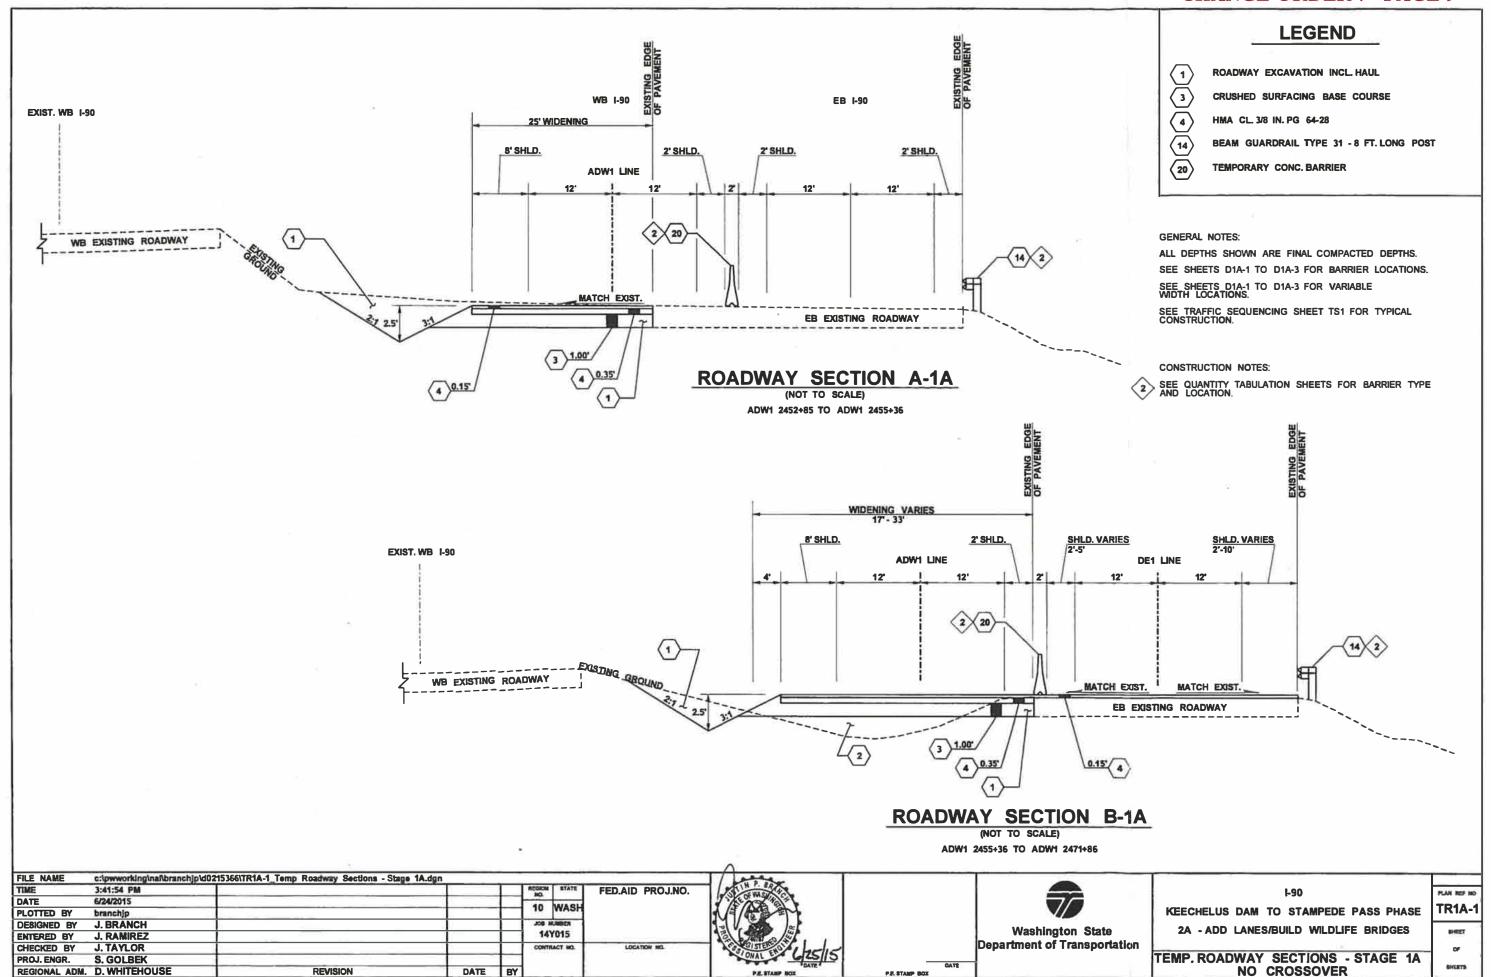

						QU	ANT	ITY 7	ΓABU	LATI	ON -	STA	GE 1						
<u> </u>		-		1						_	- 1		- ·		- 1			GENERAL NOTES:	
REFER REFER CONST	RST NUMBER OF THE "CODE" BELOW RS TO THE SHEET NO. OR THE SHEET RENCE NO. SHOWING THE FRUCTION FEATURE.  ECOND NUMBER REFERS TO THE FRUCTION FEATURE FOUND ON THAT	REMOVING CONC. BARRIER*	REMOVING GUARDRAIL*	REMOVING GUARDRAIL ANCHOR*		BEAM GUARDRAIL TYPE 31 - 8 FT. LONG POST*	WEATHERING ST. BEAM GUARDRAIL TYPE 31*	BEAM GUARDRAIL TYPE 31		BEAM GUARDRAIL TRANSITION SECTION TYPE 21*	BEAM GUARDRAIL TYPE 31 NON-FLARED TERMINAL	BEAM GUARDRAIL ANCHOR TYPE 10		BARRIER GAP	TEMPORARY CONC. BARRIER*	TEMPORARY IMPACT ATTENUATOR	SEE GENERAL NOTES	GENERAL NOTES.	
	LOCATION Y \ UNIT OF MEASURE >	L.F.	L.F.	EACH		L.F.	L.F.	L.F.		EACH	EACH	EACH		EACH	L.F.	EACH			
	DW1 10+00 - DW1 141+00 DE1 10+00 - DE1 128+00					- 1									1		6	 	ALLBE
2	DET 10+00 - DET 128+00																Ь	ONE OF THE FOLLOWING: ABSORB 350, TR	RITON
	S 21+13 - S 41+08					- 1											- N	CET, OR TRACC AND SHALL INCLUDE SIGN 501.	N W12-
	EV 10.00 EV 19.72	- !																	
<del>   </del>	EX 10+00 - EX 18+73 41+19.30 (14' RT)			1		- 1									7793.5			2. THIS BARRIER SHALL BE ANCHORED IN STA. DW1 89+67 TO STA. DW1 98+58.	ITO HMA
D1-1 1	DW1 -10+00 (10' RT) - DE1 106+78 (16' LT)			i i		i	i		i i					71 <del>-115 -</del>	10012.5		3, 4, 6, 8	31A. DW1 85+07 10 31A. DW1 50+30.	
D1-1 2	DW1 10+15 (14' LT) - DW1 14+15 (14' LT)	j		<u> </u>		1	i								412.5	1	1, 4, 6	3. SEE SHEET TDE3 FOR TEMPORARY GLA	
	DW1 10+54 (76' LT) - DW1 11+98 (68' LT)		220	1 1		- 1	!										===	SCREEN DETAIL. SEE SPECIAL PROVISION "CONCRETE BARRIER."	١
D1-1 4 [	DW1 10+72 (124' LT) - DW1 12+13 (122' LT) DW1 20+25 (14' LT) - DW1 42+44 (20' LT)		220	1										12	2162.5	1	1, 4, 6	CONONETE BANNIEN.	
D1-1 31	THE ENTED (14 LT) OWT 4244 (20 LT)													10	2102:0		41-11-0	4. SEE SHEET TDE-4 FOR TEMP. CONC. BA	ARRIER
D1-2 1	DE1 10+00 (23' RT) - DE1 50+18 (19' RT)	4030																DETAIL.	
D1-2 2	DE1 10+00 (25' RT) - DE1 10+23 (23' RT)	Ì		i i			i		i i	1							7	5. GUARDRAIL POSTS SHALL REQUIRE	
	DE1 10+23 (23' RT) - DE1 10+98 (23' RT)														75		4, 6	INSTALLATION IN HMA ADJACENT TO CON-	IC.
	DE1 10+94 (23' RT) - DE1 23+26 (23' RT) DE1 23+28 (22' RT)					1112.5	- !			2					75		5, 7 4, 6	BARRIER.	
01-3 11	DEI 25+25 (25 HI) - DEI 25+56 (22 HI)			1			1			-					/5		4, 0	! I 6. SEE SPECIAL PROVISION "GUIDE POSTS	S."
D1-3 2	DE1 23+94 (22' RT) - DE1 30+86 (17' RT)	i		i		587.5				2							5, 7		
D1-3 3 [	DE1 30+83 (17' RT) - DE1 31+58 (16' RT)			i i											75		4, 6	7. TYPE B CONNECTION TO CONCRETE BA REQUIRED.	ARRIER
	DE1 31+54 (16' RT) - DE1 44+31 (17' RT)			1 1		1162.5				2							5, 7	REQUIRED.	
	DW1 55+44 (20' LT) - DW1 58+94 (20' LT) DE1 44+31 (17' RT) - DE1 44+99 (18' RT)			1 1								ļ		6	325	_ 1	1, 4, 6	8. TEMPORARY GLARE SCREEN ENDS AT I	DW1
D1-4 21L	DEI 44+31 (17 KI) - DEI 44+99 (16 KI)			1							- 6				75		4, 6	101+00 (46' RT)	
D1-4 3	DE1 44+99 (18' RT) - DE1 50+38 (24' RT)			i i		475				1		1					5,7	THIS ITEM APPEARS ON MULTIPLE QUAN	NTITY
D1-5 1	DW1 68+77 (20' LT) - DW1 74+89 (20' LT)			İ					i					4	600	1	1, 4, 6	TABULATION OR STRUCTURE NOTE SHEE	TS. SEE
D1-5 2	DW1 69+25 (185' LT) - DW1 73+93 (151' LT)		470	1 1														SHEETS SNQT1 - SNQT2 FOR PROJECT TO	OTALS.
	DW1 83+11 (97' LT) - DW1 83+51 (100' LT)   DW1 83+85 (101' LT) - DW1 85+22 (102' LT)	40	140																
01-0 2	DAA 1 00+00 (101 F1) - DAA 1 02+55 (105 F1)		140															{	
D1-7 1	DW1 89+67 (20' LT) - DW1 107+80 (20' LT)													10	1775	1	1, 2, 4, 6	i .	
D1-7 2	DW1 95+42 (145' LT) - DW1 96+63 (178' LT)		130	1									1						
	DE1 85+64 (20' RT) - DE1 108+56 (20' RT)		076							1				2	2287.5		4, 6, 7		
	DE1 85+08 (24' RT) - DE1 88+47 (161' RT) DW1 114+37 (16' RT) - DW1 120+11 (50' RT)		370	1 1	<u> </u>				1						587.5		3, 4, 6	-	
01-0 111															G.100		3, 4, 0	1	
																		1	
	DW1 122+97 (20' LT) - DW1 129+36 (20' LT)			1 1											650	1	1, 4, 6		
D1-9 2	DW1 124+91 (20' LT) - DW1 129+36 (35' LT)														350		1, 4, 6	-	
	SHEET TOTAL	4070	1550	6		3337.5				9		1 1		93 150	15081 2 <del>0262.5</del>	<del>-0- 5</del>			
							STATE	FED. AID	PROJ. NO.									100	1
																	VEEO::-	I-90	QS1-1
	ED BY S. ROBERT				<u> </u>	10	WASH							_			1.	LUS DAM TO STAMPEDE PASS PHASE	CUEST
	D BY B. CUILLIER					JOR NI	JMBER						75 K	lashington Separtment	State of Transpo	rtation	2A - AD	D LANES / BUILD WILDLIFE BRIDGES	SHEET 46
	NGR. J. HEILMAN-SUAREZ				4:	14Y								Per enterit	. J			******	] 46   OF
	ADM. D. WHITEHOUSE					CONTRA												QUANTITY TABULATION - STAGE 1	788
	DATE DATE		REVISION		BY														SHEETS


Г						<u> </u>		ITV 7				CTA	OF 1						
						QU	ANI	II Y I	TABU	LAH	ON -	SIA	GE 1						
REFE CON	FIRST NUMBER OF THE "CODE" BELOW ERS TO THE SHEET NO. OR THE SHEET ERENCE NO. SHOWING THE STRUCTION FEATURE.  SECOND NUMBER REFERS TO THE STRUCTION FEATURE FOUND ON THAT	RESETTING IMPACT	TEMPORARY RIGID GUIDE POST (TYPE W)*	TEMPORARY RIGID GUIDE POST (TYPE Y)*		LDS BARRIER DELINEATOR (TYPE W)*	LDS BARRIER DELINEATOR (TYPE Y)*	SNOW POLE*		PAINT LINE	AINTED STOP LINE		TEMPORARY PAVEMENT MARKING-LONG DURATION*	TEMPORARY GLARE SCREEN*			SEE GENERAL NOTES	GENERAL NOTES:	
CODE	LOCATION V \ UNIT OF MEASURE >	EACH	EACH	EACH		EACH	EACH	EACH		L.F.	L.F.		L.F.	L.F.			l o		
	DW1 10+00 - DW1 141+00		28	8				263					117900				6		
	DE1 10+00 - DE1 128+00		42	13				237				Λ )	106200				6	1. TEMPORARY IMPACT ATTENUATOR SH/ ONE OF THE FOLLOWING: ABSORB 350, TI	
-	IS 21+13 - S 41+08		1		[					2000					1	- 1		CET, OR TRACC AND SHALL INCLUDE SIGN	
	0 21710-0 41400		1							2000								501.	
	EX 10+00 - EX 18+73									2000				i	i			2. THIS BARRIER SHALL BE ANCHORED IN	
	41+19.30 (14' RT)						243							5 <b>7</b> 91				STA. DW1 89+67 TO STA. DW1 98+58.	II O I IIVIA
	DW1 -10+00 (19' RT) - DE1 106+78 (16' LT)						330							8810			3, 4, 6, 8		
	PDW1 10+15 (14' LT) - DW1 14+15 (14' LT)  BDW1 10+54 (76' LT) - DW1 11+98 (68' LT)					9											1, 4, 6	3. SEE SHEET TDE3 FOR TEMPORARY GLA SCREEN DETAIL. SEE SPECIAL PROVISION	
	IDW1 10+54 (76° LT) - DW1 11+98 (68° LT)	-	1															SCREEN DE LAIL. SEE SPECIAL PROVISION   "CONCRETE BARRIER."	N
	DW1 10+72 (124 L1) - DW1 12+13 (122 L1)					49											1, 4, 6		
						,,,											11,110	4. SEE SHEET TDE-4 FOR TEMP. CONC. BA	ARRIER
	DE1 10+00 (23' RT) - DE1 50+18 (19' RT)	-																DETAIL.	
D1-2 2	PDE1 10+00 (25' RT) - DE1 10+23 (23' RT)							<u> </u>								Į.	7	5. GUARDRAIL POSTS SHALL REQUIRE	
	B DE1 10+23 (23' RT) - DE1 10+98 (23' RT)		1			2									ļ.		4, 6	INSTALLATION IN HMA ADJACENT TO CON	IC.
	DE1 10+94 (23' RT) - DE1 23+26 (23' RT)					_											5, 7 4, 6	BARRIER.	
ו ג-וט	DE1 23+23 (23' RT) - DE1 23+98 (22' RT)		-			2								-			4, 0	   6. SEE SPECIAL PROVISION "GUIDE POSTS	S.*
D1-3 2	DE1 23+94 (22' RT) - DE1 30+86 (17' RT)		1												1		5, 7	0.0220 Ediner Hovidion ddiberoord	٥.
	B DE1 30+83 (17' RT) - DE1 31+58 (16' RT)		i			3			i						i		4, 6	7. TYPE B CONNECTION TO CONCRETE BA	ARRIER
D1-3 4	DE1 31+54 (16' RT) - DE1 44+31 (17' RT)																5, 7	REQUIRED.	
	DW1 55+44 (20' LT) - DW1 58+94 (20' LT)					5									]		1, 4, 6	8. TEMPORARY GLARE SCREEN ENDS AT	DW1
D1-4_2	DE1 44+31 (17' RT) - DE1 44+99 (18' RT)					2											4, 6	101+	
D1 4 5	B DE1 44+99 (18' RT) - DE1 50+38 (24' RT)		Li -														5, 7	00 (46' RT)	
	IDW1 68+77 (20' LT) - DW1 74+89 (20' LT)		-			8											1, 4, 6	! │ ↑ THIS ITEM APPEARS ON MULTIPLE QUAN	NTITY
	2 DW1 69+25 (185' LT) - DW1 73+93 (151' LT)											i					1, 7, 0	TABULATION OR STRUCTURE NOTE SHEE	
D1-6 1	DW1 83+11 (97' LT) - DW1 83+51 (100' LT)		l .															SHEETS SNQT1 - SNQT2 FOR PROJECT TO	OTALS.
	DW1 83+85 (101' LT) - DW1 85+22 (102' LT)											1							
2																			
	DW1 89+67 (20' LT) - DW1 107+80 (20' LT)					30						1					1, 2, 4, 6		
	PDW1 95+42 (145' LT) - DW1 96+63 (178' LT) BDE1 85+64 (20' RT) - DE1 108+56 (20' RT)		1		I	l I 44		l				I .			<u>.                                    </u>		4, 6, 7		
	DE1 85+08 (24' RT) - DE1 108+36 (20 RT)					44			1								7,0,7		
	DW1 114+37 (16' RT) - DW1 120+11 (50' RT)	[	1				8					i		580			3, 4, 6	i	
	1.00					i	-								3.0			i'	
	DW1 122+97 (20' LT) - DW1 129+36 (20' LT)					8											1, 4, 6		
D1-9 2	2 DW1 124+91 (20' LT) - DW1 129+36 (35' LT)	1										1		6074			1, 4, 6	-	
-	SHEET TOTAL	1	1 70	21		113 156	251 -344	500		4000		1	-224100-	6371 -0300-				1	
	J J J		1 70	21		REGION NO.		FED. AID	PROJ NO	7000			LL-FIOO	-0000				I-	1
						TEGION NO.	JIAIL	וויייייייייייייייייייייייייייייייייייי										I-90	QS1-2
DESIG	NED BY S. ROBERT					10	WASH						_				KEECHE	LUS DAM TO STAMPEDE PASS PHASE	
ENTER	RED BY B. CUILLIER					<u> </u>							🐬 Y	Vashington	State of Transpo		2A - AD	D LANES / BUILD WILDLIFE BRIDGES	SHEET
	KED BY L. HUCK					3.	UMBER	1						Department	of Transpo	rtation			47
	ENGR. J. HEILMAN-SUAREZ						/015	1										OLIANITITY TABLE ATION STACE 4	OF
HEGIC	ON ADM.  D. WHITEHOUSE   DATE   DATE		REVISION		l BY	CONTR	ACT NO.										1 '	QUANTITY TABULATION - STAGE 1	788 SHEETS
	DATE   DATE		UE A IOION		DI														SHEETS

					QL	JANT	ITY 1	<b>TABU</b>	LATI	ON -	STA	GE 1					
NOTE: THE FIRST NUMBER OF THE "CODE" BELOW REFERS TO THE SHEET NO. OR THE SHEET REFERENCE NO. SHOWING THE CONSTRUCTION FEATURE.  THE SECOND NUMBER REFERS TO THE CONSTRUCTION FEATURE FOUND ON THAT SHEET.	REMOVING CONC. BARRIER*	REMOVING GUARDRAIL*	REMOVING GUARDRAIL ANCHOR*		BEAM GUARDRAIL TYPE 31 - 8 FT. LONG POST*	WEATHERING ST. BEAM GUARDRAIL TYPE 31*	BEAM GUARDRAIL TYPE 31		BEAM GUARDRAIL TRANSITION SECTION TYPE 21*	BEAM GUARDRAIL TYPE 31 NON-FLARED TERMINAL	BEAM GUARDRAIL ANCHOR TYPE 10		BARRIER GAP•	TEMPORARY CONC. BARRIER	TEMPORARY IMPACT ATTENUATOR	SEE GENERAL NOTES	GENERAL NOTES:
CODE LOCATION ▼ \ UNIT OF MEASURE ➤ PS-1 1 S 20+32 · S 20+32 (14.1' RT)	L.F.	L.F.	EACH		L.F.	L.F.	L.F.		EACH	EACH	EACH		EACH	L.F.	EACH		
PS-3 1 S 34+20 (16' LT) - S 39+72 (14' LT) PS-3 2 S 34+30 (13.3' LT) - S 39+68 (13.4' LT) PS-3 3 S 38+60 (16' RT) - S 39+72 (14' RT) PS-3 4 S 39+08 (21.2' RT) - S 39+68 (14.4' RT)		540	1				500 62.5		1	1				112		7	1. TEMPORARY IMPACT ATTENUATOR SHALL BE ONE OF THE FOLLOWING: ABSORB 350, TRITON CET, OR TRACC AND SHALL INCLUDE SIGN W12- 501.
PS-5 1 EX 10+29 (99' RT) - EX 11+41 (91' RT)		210				407.5											2. THIS BARRIER SHALL BE ANCHORED INTO HMA STA. DW1 89+67 TO STA. DW1 98+58.
PS-5 2 EX 10+29 (99' RT) - EX 11+41 (91' RT)					-	187.5											3. SEE SHEET TDE3 FOR TEMPORARY GLARE SCREEN DETAIL. SEE SPECIAL PROVISION "CONCRETE BARRIER."
																	4. SEE SHEET TDE-4 FOR TEMP. CONC. BARRIER DETAIL.
																	5. GUARDRAIL POSTS SHALL REQUIRE INSTALLATION IN HMA ADJACENT TO CONC. BARRIER.
			 												<u> </u>		6. SEE SPECIAL PROVISION "GUIDE POSTS."
																	7. TYPE B CONNECTION TO CONCRETE BARRIER REQUIRED.
																	8. TEMPORARY GLARE SCREEN ENDS AT DW1 101+00 (46' RT)
																	* THIS ITEM APPEARS ON MULTIPLE QUANTITY TABULATION OR STRUCTURE NOTE SHEETS. SEE SHEETS SNQT1 - SNQT2 FOR PROJECT TOTALS.
SHEET TOTAL		   810	2			187.5	562.5		     2	1 2			93	15081			-
PROJECT TOTAL		2360	8		3337.5   REGION NO.	187.5	562.5 FED. AID	BBO L NO	11	2	1		<del>150-</del>	20262.5	€ 5		1
DESIGNED BY  S. ROBERT					10	WASH	FEU. AID	PROJ. NO.				<b>*</b>	Vashington Department	State of Transpo	ortation		I-90 ELUS DAM TO STAMPEDE PASS PHASE DD LANES / BUILD WILDLIFE BRIDGES SHEET 48
PROJ. ENGR. J. HELMAN-SUAREZ   REGION ADM.   D. WHITEHOUSE   DATE   DATE		REVISION		BY	14\	/015 ACT NO.							,				QUANTITY TABULATION - STAGE 1 788 SHEETS


					QU	ANT	ITY T	TABU	LATI	ON -	STA	GE 1						
NOTE: THE FIRST NUMBER OF THE "CODE" BELOW REFERS TO THE SHEET NO. OR THE SHEET REFERENCE NO. SHOWING THE CONSTRUCTION FEATURE.  THE SECOND NUMBER REFERS TO THE CONSTRUCTION FEATURE FOUND ON THAT SHEET.	RESETTING IMPACT	TEMPORARY RIGID GUIDE POST (TYPE W)*	TEMPORARY RIGID GUIDE POST (TYPE Y)*		LDS BARRIER DELINEATOR (TYPE W)*	LDS BARRIER DELINEATOR (TYPE Y)*	SNOW POLE		AINT LINE	AINTED STOP LINE		TEMPORARY PAVEMENT MARKING-LONG DURATION*	EMPORARY GLARE SCREEN*			GENERAL NOTES	GENERAL NOTES:	
CODE LOCATION Y \ UNIT OF MEASURE >  PS-1 1 S 20+32 - S 20+32 (14.1' RT)  PS-3 1 S 34+20 (16' LT) - S 39+72 (14' LT)  PS-3 2 S 34+30 (13.3' LT) - S 39+68 (13.4' LT)  PS-3 3 S 38+60 (16' RT) - S 39+72 (14' RT)  PS-3 4 S 39+08 (21.2' RT) - S 39+68 (14.4' RT)	EACH	EACH	₽ Q EACH		<u>Š</u> È EACH	ŠĘ EACH	EACH		L.F.	L.F. 14		L.F.	L.F.			ш 7 7	TEMPORARY IMPACT ATTENUATOR SHA     ONE OF THE FOLLOWING: ABSORB 350, TF     CET, OR TRACC AND SHALL INCLUDE SIGN     501.	RITON
PS-5 1 EX 10+29 (99' RT) - EX 11+41 (91' RT) PS-5 2 EX 10+29 (99' RT) - EX 11+41 (91' RT)																	2. THIS BARRIER SHALL BE ANCHORED INT STA. DW1 89+67 TO STA. DW1 98+58. 3. SEE SHEET TDE3 FOR TEMPORARY GLA SCREEN DETAIL. SEE SPECIAL PROVISION "CONCRETE BARRIER."	ARE
																	4. SEE SHEET TDE-4 FOR TEMP. CONC. BADETAIL.  5. GUARDRAIL POSTS SHALL REQUIRE INSTALLATION IN HMA ADJACENT TO CONC BARRIER.  6. SEE SPECIAL PROVISION *GUIDE POSTS	C.
						5											7. TYPE B CONNECTION TO CONCRETE BA REQUIRED.  8. TEMPORARY GLARE SCREEN ENDS AT E 101+00 (46' RT)	RRIER
																	* THIS ITEM APPEARS ON MULTIPLE QUAN TABULATION OR STRUCTURE NOTE SHEET SHEETS SNQT1 - SNQT2 FOR PROJECT TO	TS. SEE
SHEET TOTAL PROJECT TOTAL	1	 	1 21		113 356 REGION NO.	251 344 STATE	500 FED. AID	I I I PROJ. NO.	4000	14		-224100	6371 -9390				I-90	QS1-4
DESIGNED BY S. ROBERT ENTERED BY B. CUILLIER CHECKED BY L. HUCK PROJ. ENGR. J. HELMAN-SUAREZ REGION ADM. D. WHITEHOUSE DATE DATE		REVISION		l           BY	14Y	WASH JMBER '015 ACT NO.						<b>**</b>	Vashington Jepartment	State t of Transpo	ortation	2A - AD	LUS DAM TO STAMPEDE PASS PHASE D LANES / BUILD WILDLIFE BRIDGES QUANTITY TABULATION - STAGE 1	SHEET 49 OF 788 SHEETS

							QU	ANTI	TY T	ABUL	ATIO	- NC	STAC	GE 1/	4					
NOTE: THE FIRST NUMBER OF THE "COREFERS TO THE SHEET NO. OR REFERENCE NO. SHOWING THE CONSTRUCTION FEATURE.  THE SECOND NUMBER REFERS CONSTRUCTION FEATURE FOU SHEET.	THE SHEE E TO THE ND ON THA	T T	REMOVING CONC. BARRIER*	REMOVING GUARDRAIL*	REMOVING GUARDRAIL ANCHOR*		BEAM GUARDRAIL TYPE 31 - 8 FT. LONG POST*	WEATHERING ST. BEAM GUARDRAIL TYPE 31*	BEAM GUARDRAIL TYPE 31		BEAM GUARDRAIL TRANSITION SECTION TYPE 21*	BEAM GUARDRAIL TYPE 31 NON-FLARED TERMINAL	BEAM GUARDRAIL ANCHOR TYPE 10	-	BARRIER GAP*	TEMPORARY CONC. BARRIER*	TEMPORARY IMPACT ATTENUATOR	SEE GENERAL NOTES	GENERAL NOTES:	
CODE	3+43.46		L.F.	L.F.	EACH			L.F.	L.F.		EACH	EACH	EACH		58	2934 2934	EACH	1, 2, 3	1. SEE SHEET TDE3 FOR TEMPORARY GLA SCREEN DETAIL. SEE SPECIAL PROVISION "CONCRETE BARRIER."  2. SEE SHEET TDE-4 FOR TEMP. CONC. BAIDETAIL.  3. SEE SPECIAL PROVISION "GUIDE POSTS.  * THIS ITEM APPEARS ON MULTIPLE QUANTABULATION OR STRUCTURE NOTE SHEET SHEETS SNQT1 - SNQT2 FOR PROJECT TOTAL STRUCTURE.  ** SNQT1 - SNQT2 FOR PROJECT TOTAL SNQT2 FOR PROJECT TOTAL SNQT3 FOR PROJECT FOR PROJE	ARRIER  3."  ITITY  IS. SEE
	SHEET	TOTAL	-	×				CTATE							58	2934				
DESIGNED BY J. BRANCH ENTERED BY M. PANICK CHECKED BY A. SCHARLE								WASH UMBER	FED. AID	PROJ. NO.				<b>₩</b>	/ashington Jepartme <i>nt</i>	State of Transpo	rtation		I-90 LUS DAM TO STAMPEDE PASS PHASE D LANES / BUILD WILDLIFE BRIDGES	QS1A-
PROJ. ENGR.   S. GOLBEK   REGION ADM.   D. WHITEHOUSE	DATE	DATE		REVISION	•	BY	CONTR	'015 <b>ACT NO.</b>										Q	UANTITY TABULATION - STAGE 1A	OF SHEETS

						QU	ANTI	TY T	ABUL	ATIO	- NC	STA	GE 1/	Α					
REFE REFE CONS	FIRST NUMBER OF THE "CODE" BELOW RS TO THE SHEET NO. OR THE SHEET RENCE NO. SHOWING THE STRUCTION FEATURE. SECOND NUMBER REFERS TO THE STRUCTION FEATURE FOUND ON THAT	RESETTING IMPACT	TEMPORARY RIGID GUIDE POST (TYPE W)*	TEMPORARY RIGID GUIDE POST (TYPE Y)*		LDS BARRIER DELINEATOR (TYPE W)*	LDS BARRIER DELINEATOR (TYPE Y)*	SNOW POLE•		PAINT LINE	PAINTED STOP LINE		TEMPORARY PAVEMENT MARKING-LONG DURATION*	TEMPORARY GLARE SCREEN*			SEE GENERAL NOTES	GENERAL NOTES:	
CODE	LOCATION Y \ UNIT OF MEASURE > DW1 10+00 - DW1 48+00	EACH	EACH	EACH		EACH	EACH	EACH		L.F.	L.F.		L.F. 39254	L.F.			S		
	ADW1 2446+75.51 - DE1 33+43.46											1	39254 37980					1 CEE CHEET TOE? FOR TEMPORARY CLAS	DE
D1A-1 1	DW1 10+00 (13' RT) - 48+00 (14' RT)						120							2934			1, 2, 3	SEE SHEET TDE3 FOR TEMPORARY GLAI     SCREEN DETAIL. SEE SPECIAL PROVISION     "CONCRETE BARRIER."	
	3																	2. SEE SHEET TDE-4 FOR TEMP. CONC. BAR DETAIL.	RRIER
																		3. SEE SPECIAL PROVISION "GUIDE POSTS."	. "
																		]   *. THIS ITEM APPEARS ON MULTIPLE QUANT   TABULATION OR STRUCTURE NOTE SHEETS	TITY S. SEE
												İ						SHEETS SNQT1 - SNQT2 FOR PROJECT TOT	
	X											i				i			
												i				į			
												İ							
																i			
												i De				i .			
																i i			
							U.												
						- 100													
																		]	
																		}	
	SHEET TOTAL		i			REGION NO.	120 STATE	FED AID	PROJ. NO.				77234	2934				i ,	
	NED BY J. BRANCH					10	WASH	י בט. אוט	. 11.00. 110.	Y.								LUS DAM TO STAMPEDE PASS PHASE	QS1A- 2
CHECK	ED BY M. PANICK ED BY A. SCHMIDTMAN ENGR. S. GOLBEK				l		JMBER '015							/ashington epartment	State of Transpo	ortation	2A - AD	D LANES / BUILD WILDLIFE BRIDGES	SHEET
	N ADM. D. WHITEHOUSE DATE DATE		REVISION		BY	CONTR				3							C	QUANTITY TABULATION - STAGE 1A	SHEETS

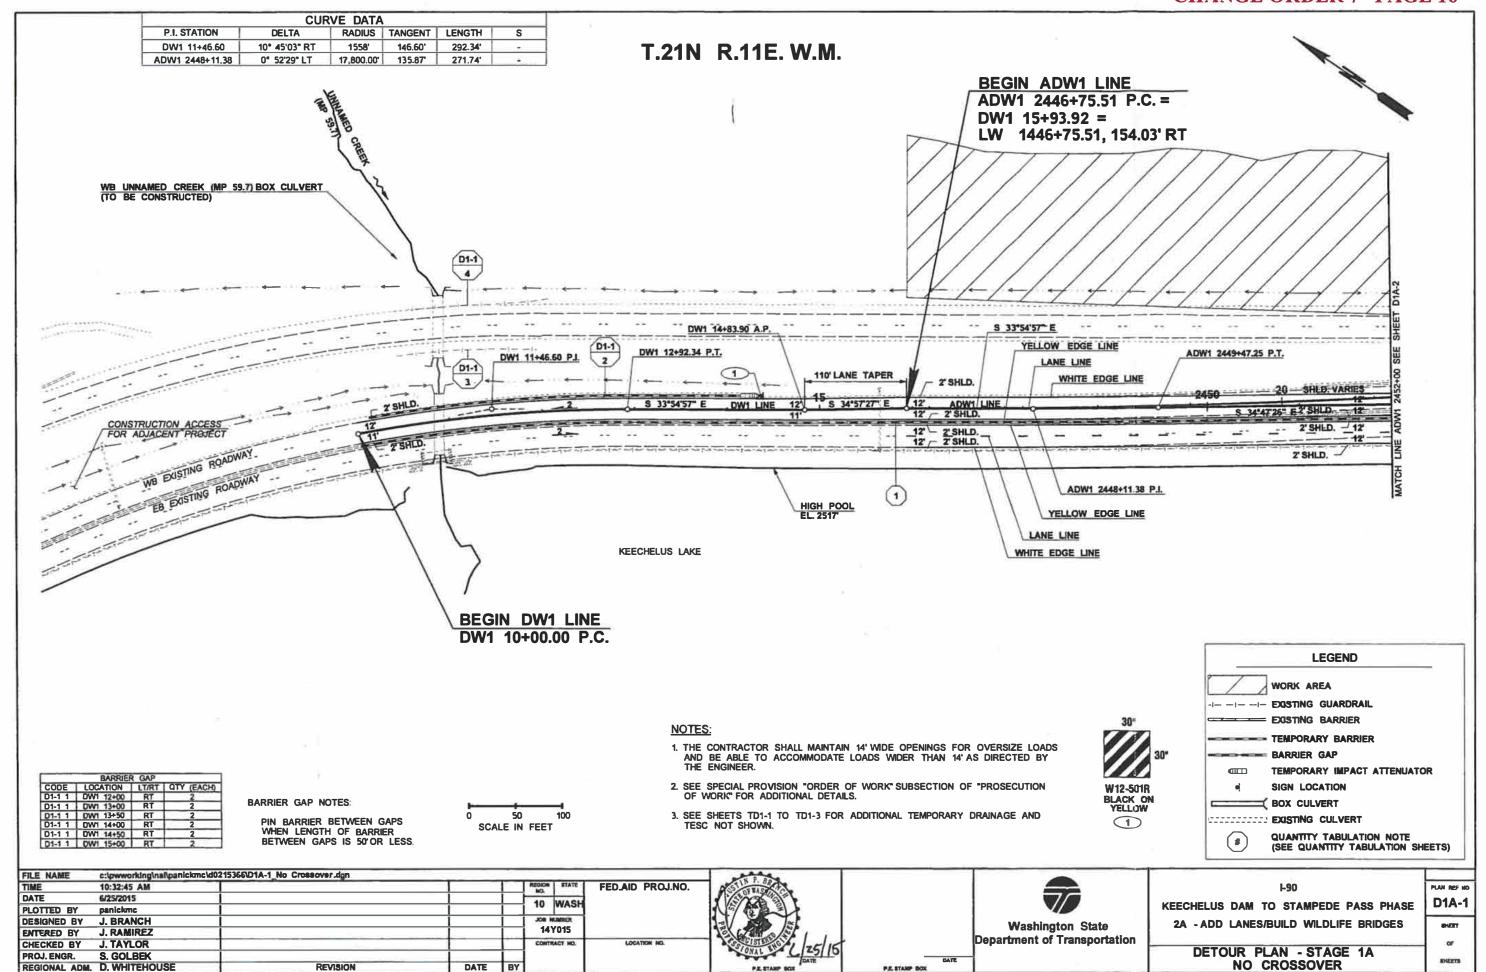


NO CROSSOVER

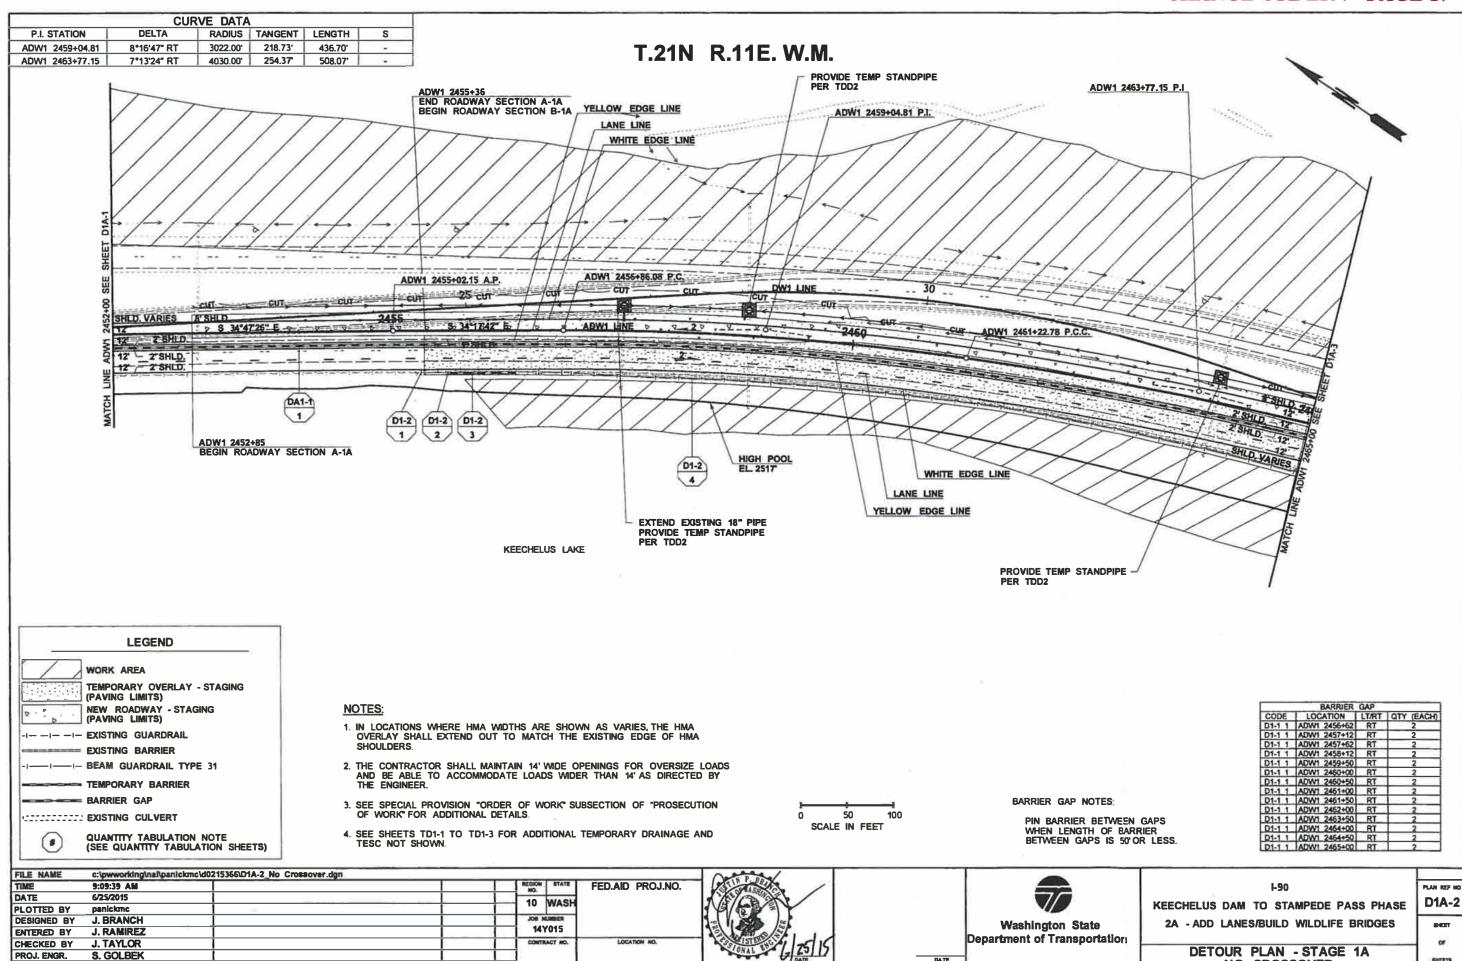


REGIONAL ADM. D. WHITEHOUSE

REVISION

DATE

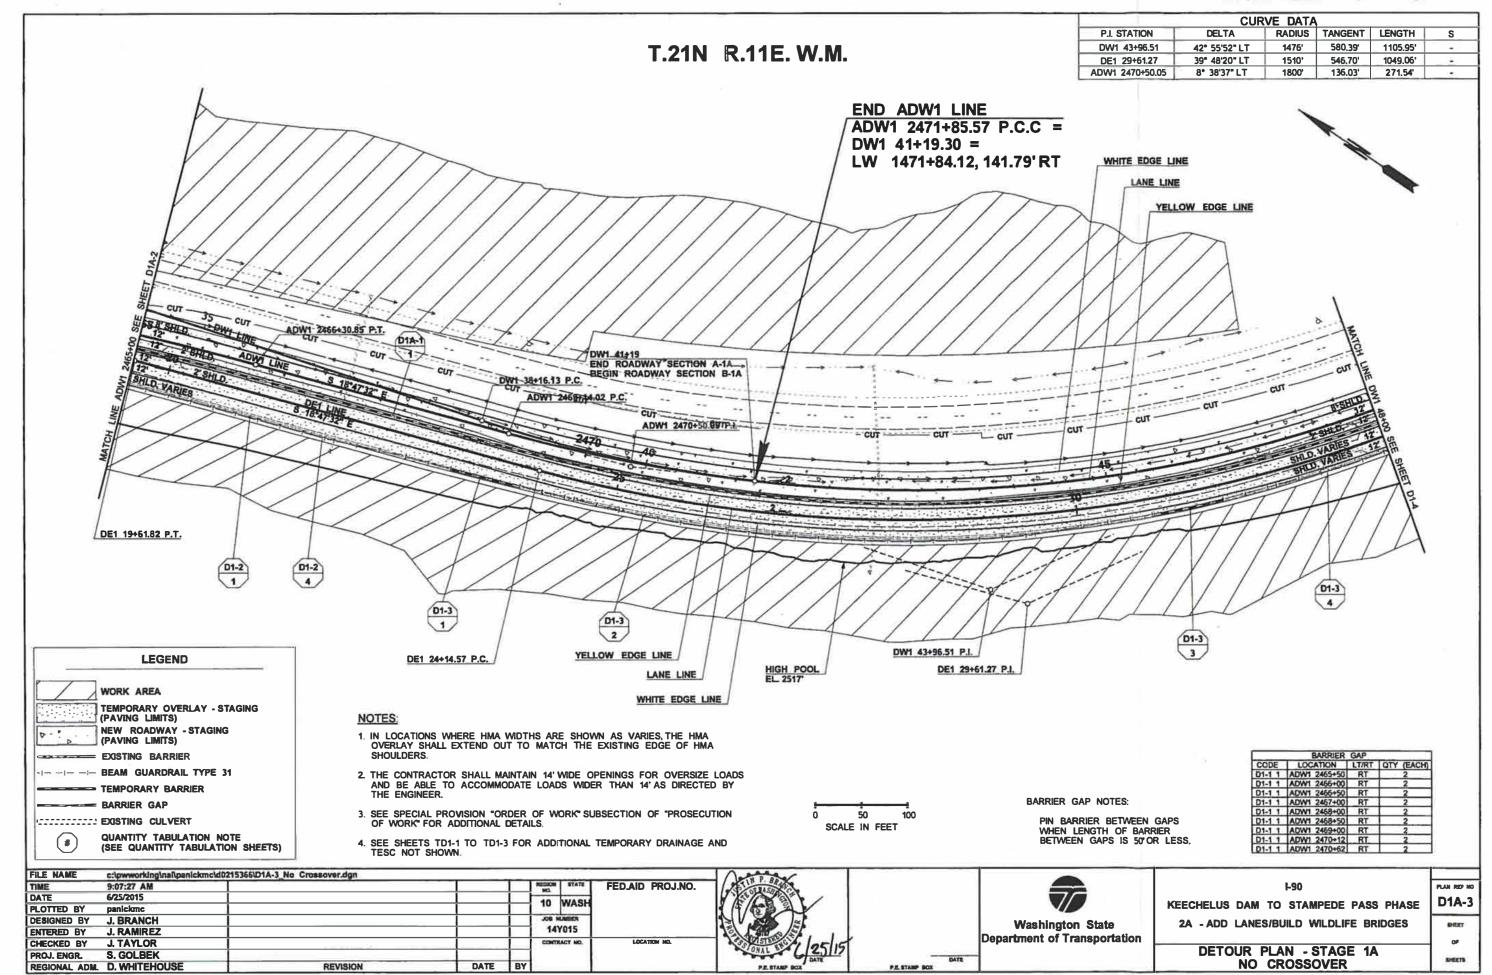

TEMP. ROADWAY SECTIONS - STAGE 1B

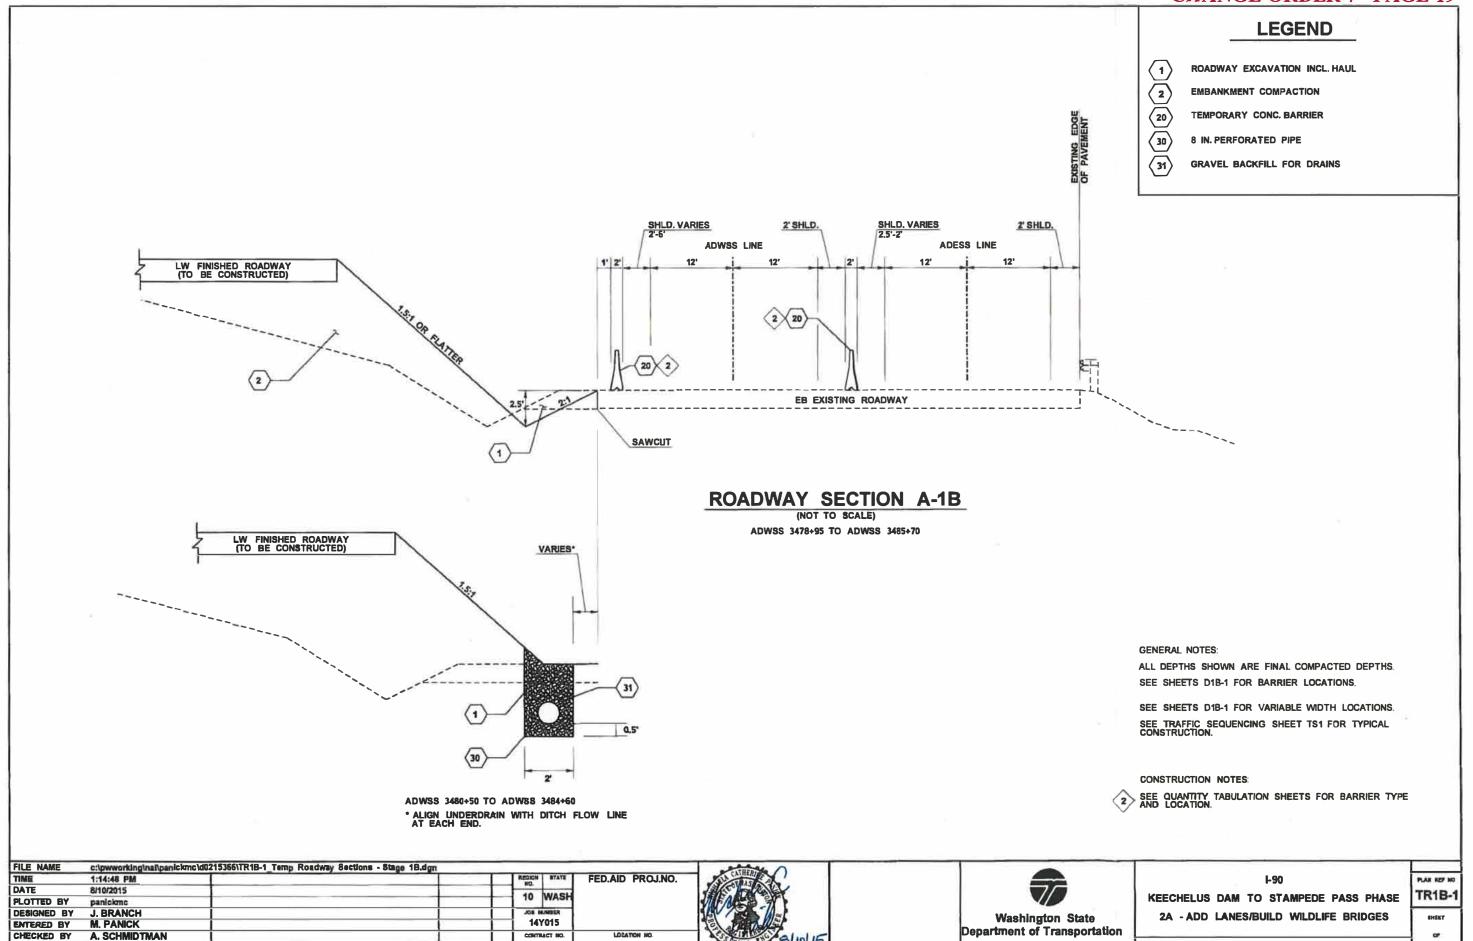

S. GOLBEK

DATE


REVISION

REGIONAL ADM. D. WHITEHOUSE

PROJ. ENGR.

								QU/	ANTI	TY T	ABUI	_ATI	- NC	STAC	3E 1I	3					
REFERS TO TREFERENCE CONSTRUCT THE SECOND CONSTRUCT SHEET.	UMBER OF THE "CO THE SHEET NO. OR NO. SHOWING THE ION FEATURE. O NUMBER REFERS ION FEATURE FOU	THE SHE	ET IAT	REMOVING CONC. BARRIER*	REMOVING GUARDRAIL*	PREMOVING GUARDRAIL DANCHOR*		BEAM GUARDRAIL TYPE 31 - 8 FT. LONG POST*	WEATHERING ST. BEAM GUARDRAIL TYPE 31*	BEAM GUARDRAIL TYPE 31		BEAM GUARDRAIL TRANSITION SECTION TYPE 21*	BEAM GUARDRAIL TYPE 31 NON-FLARED TERMINAL	BEAM GUARDRAIL ANCHOR TYPE 10		BARRIER GAP⁺	TEMPORARY CONC. BARRIER*	TEMPORARY IMPACT ATTENUATOR	SEE GENERAL NOTES	GENERAL NOTES:	
ADWSS ADESS D1B-1 1 ADWSS 3	EATION > \ UNIT O S 3477+15.98 - ADW S 3475+51.79 - ADW S 3475+51.79 - ADW S 3480+50 (14' RT) - ADW S 3480+50 (14' LT) - ADWS	/SS 3486+ SS 3485+9 SS 3486+78.8	78.84 90.67	L.F.	L.F.			L.F.	L.F.	L.F.		EACH	EACH	EACH		14 6 I	926 542	EACH	1,2,3	1. THIS BARRIER SHALL BE ANCHORED IN STA. ADWSS 3480+50 TO 3484+88.  2. SEE SHEET TDE3 FOR TEMPORARY GL SCREEN DETAIL. SEE SPECIAL PROVISION "CONCRETE BARRIER."  3. SEE SHEET TDE-4 FOR TEMP. CONC. B. DETAIL.  4. SEE SPECIAL PROVISION "GUIDE POST:  * THIS ITEM APPEARS ON MULTIPLE QUAITABULATION OR STRUCTURE NOTE SHEE	ARE N ARRIER S."
																				SHEETS SNQT1 - SNQT2 FOR PROJECT TO	
		SHEE1	T TOTAL					REGION NO.	STATE	FED. AID	PROJ. NO.					20	1468			I-90	QS1B- 1
PROJ. ENGR.	M. PANICK A. SCHMIDTMAN S. GOLBEK D. WHITEHOUSE	DATE	DATE		REVISION	н	ВУ	14)	WASH  UMBER  '015  ACT NO.							Washington Department	State of Transpo	ortation	2A - AD	LUS DAM TO STAMPEDE PASS PHASE D LANES / BUILD WILDLIFE BRIDGES UANTITY TABULATION - STAGE 1B	SHEETS

								QU	ANTI	TY T	ABUL	ATIO	ON -	STAC	GE 18	3					
REFERS TO T REFERENCE N CONSTRUCTION	UMBER OF THE "COI THE SHEET NO. OR " NO. SHOWING THE ION FEATURE. NUMBER REFERS T ION FEATURE FOUN	THE SHEE	Т	RESETTING IMPACT ATTENUATOR*	TEMPORARY RIGID GUIDE POST (TYPE W)*	TEMPORARY RIGID GUIDE POST (TYPE Y)*		LDS BARRIER DELINEATOR (TYPE W)*	LDS BARRIER DELINEATOR (TYPE Y)*	SNOW POLE*		PAINT LINE	PAINTED STOP LINE		TEMPORARY PAVEMENT MARKING-LONG DURATION*	TEMPORARY GLARE SCREEN*			SEE GENERAL NOTES	GENERAL NOTES:	
ADWSS ADESS	ATION Y \ UNIT OF S 3477+15.98 - ADWS 3475+51.79 - ADWS 3475+51.79 - ADWS 3480+50 (14' RT) - ADWS 3480+50 (14' LT) - ADWS 3480	S 3486+76 S 3485+90 S 3486+78.84	8.84 .67 (14' RT)	EACH	EACH 4	EACH		EACH	30 30 30 30 30 30 30 30 30 30 30 30 30 3	EACH		L.F.			L.F. 39254 37980	926			1,2,3 1,2,3	1. THIS BARRIER SHALL BE ANCHORED INTO STA. ADWSS 3480+50 TO 3484+88.  2. SEE SHEET TDE3 FOR TEMPORARY GLARI SCREEN DETAIL. SEE SPECIAL PROVISION "CONCRETE BARRIER."  3. SEE SHEET TDE-4 FOR TEMP. CONC. BARIDETAIL.  4. SEE SPECIAL PROVISION "GUIDE POSTS."  * THIS ITEM APPEARS ON MULTIPLE QUANTI TABULATION OR STRUCTURE NOTE SHEETS. SHEETS SNQT1 - SNQT2 FOR PROJECT TOTAL.	RE RRIER ITY 3. SEE
		SHEET	TOTAL		4	     		7	30				] ] ]	] [ ]	77234	926	   				
PROJ. ENGR.	M. PANICK A. SCHMIDTMAN S. GOLBEK D. WHITEHOUSE	DATE	DATE		REVISION		BY	14)	WASH UMBER 7015 ACT NO.	FED. AID	PKUJ. NO.				<b>**</b> **	<b>Vas</b> hington J <b>epart</b> ment	State t of Transp	portation	2A - AD	LUS DAM TO STAMPEDE PASS PHASE D LANES / BUILD WILDLIFE BRIDGES  QUANTITY TABULATION - STAGE 1B	QS1B- 2 SHEET OF SHEETS

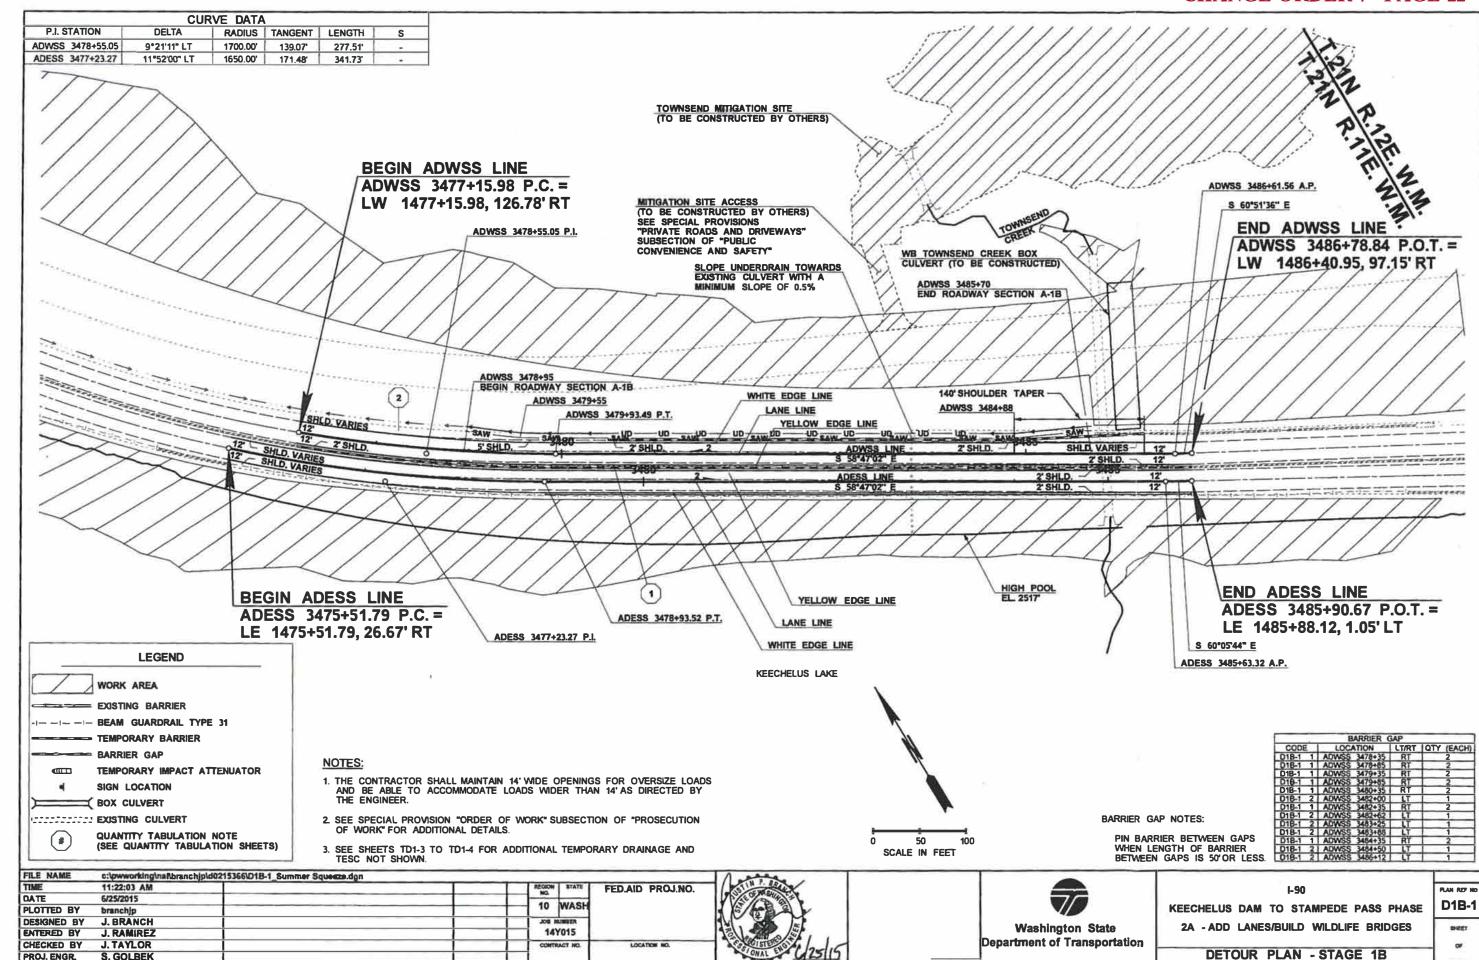


REGIONAL ADM. D. WHITEHOUSE

REVISION

DATE BY

788 SHEETS

TEMP. ROADWAY SECTIONS - STAGE 2

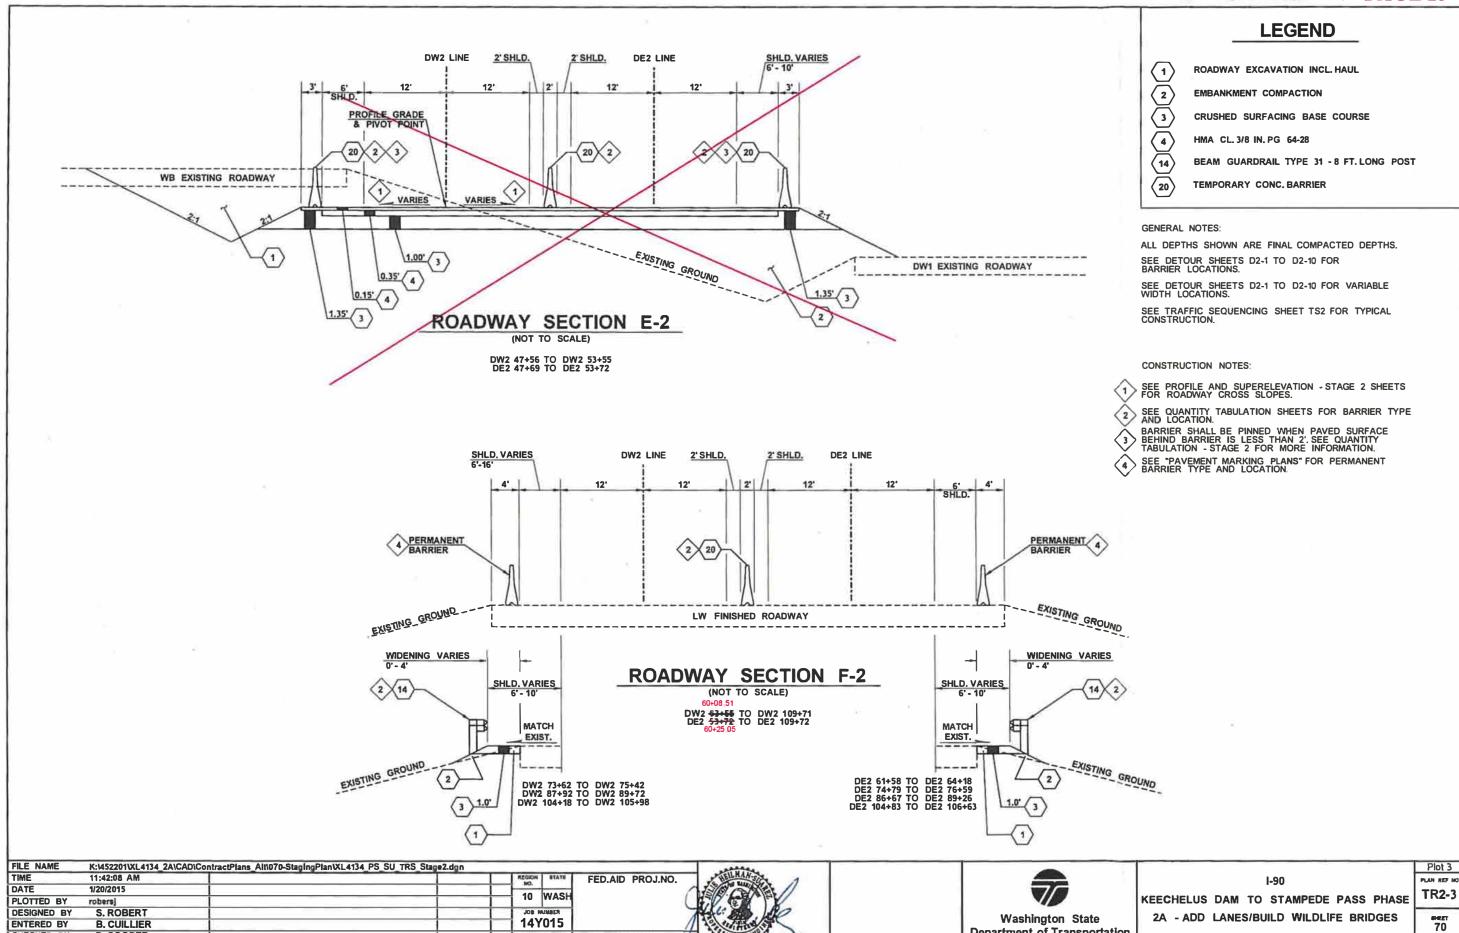

CHECKED BY

PROJ. ENGR.

P. COOPER


REGIONAL ADM. D. WHITEHOUSE

J. HEILMAN-SUAREZ

REVISION

DATE


**Department of Transportation** 

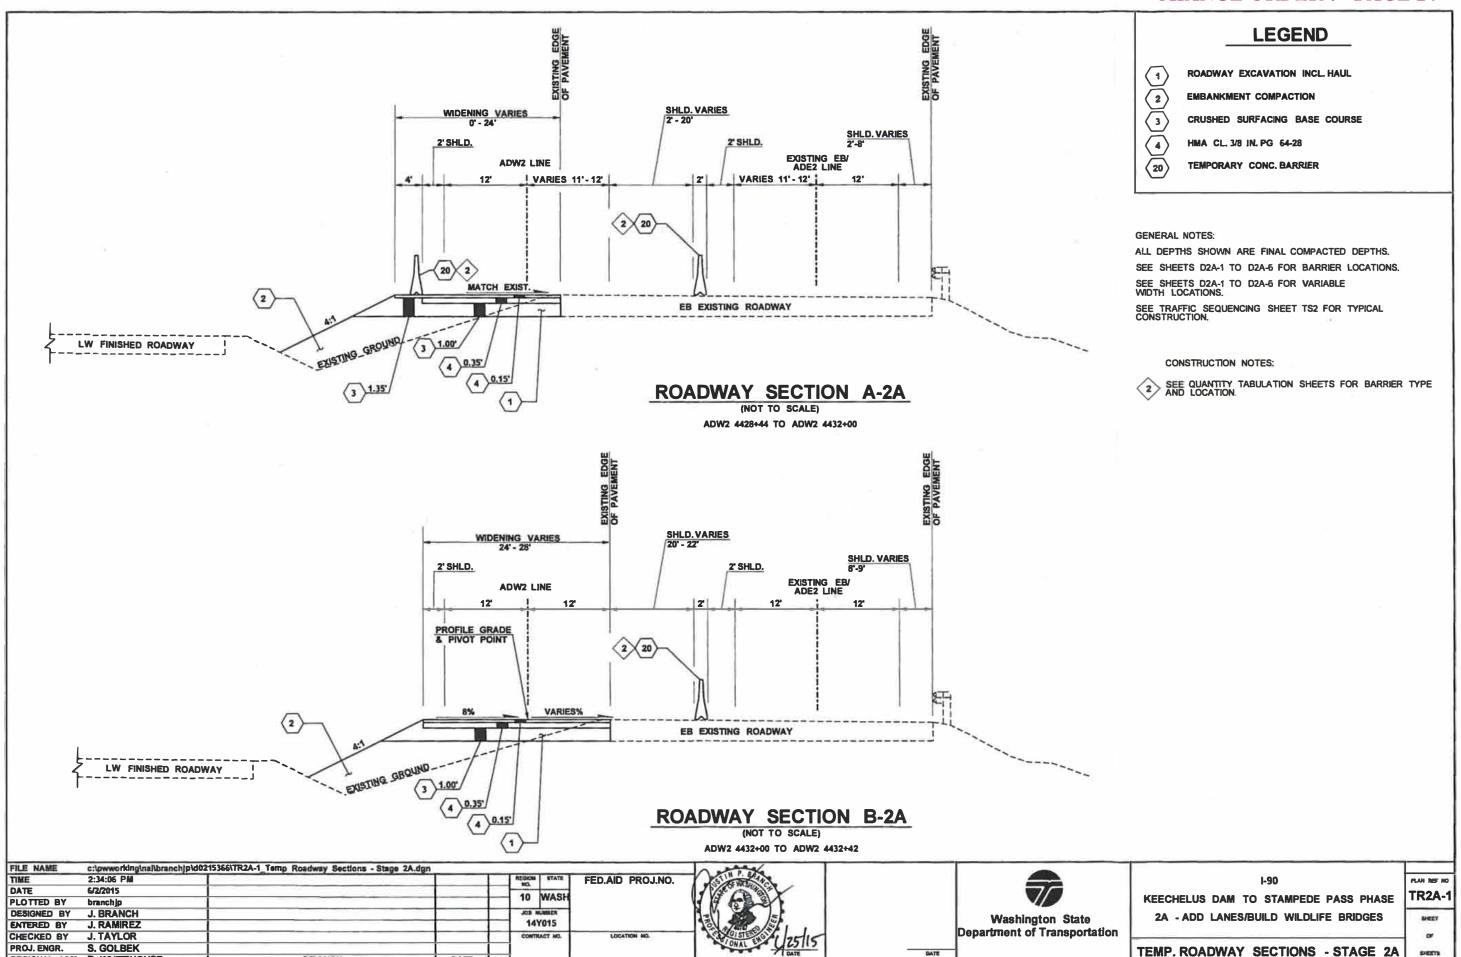

REGIONAL ADM. D. WHITEHOUSE

REVISION

DATE BY

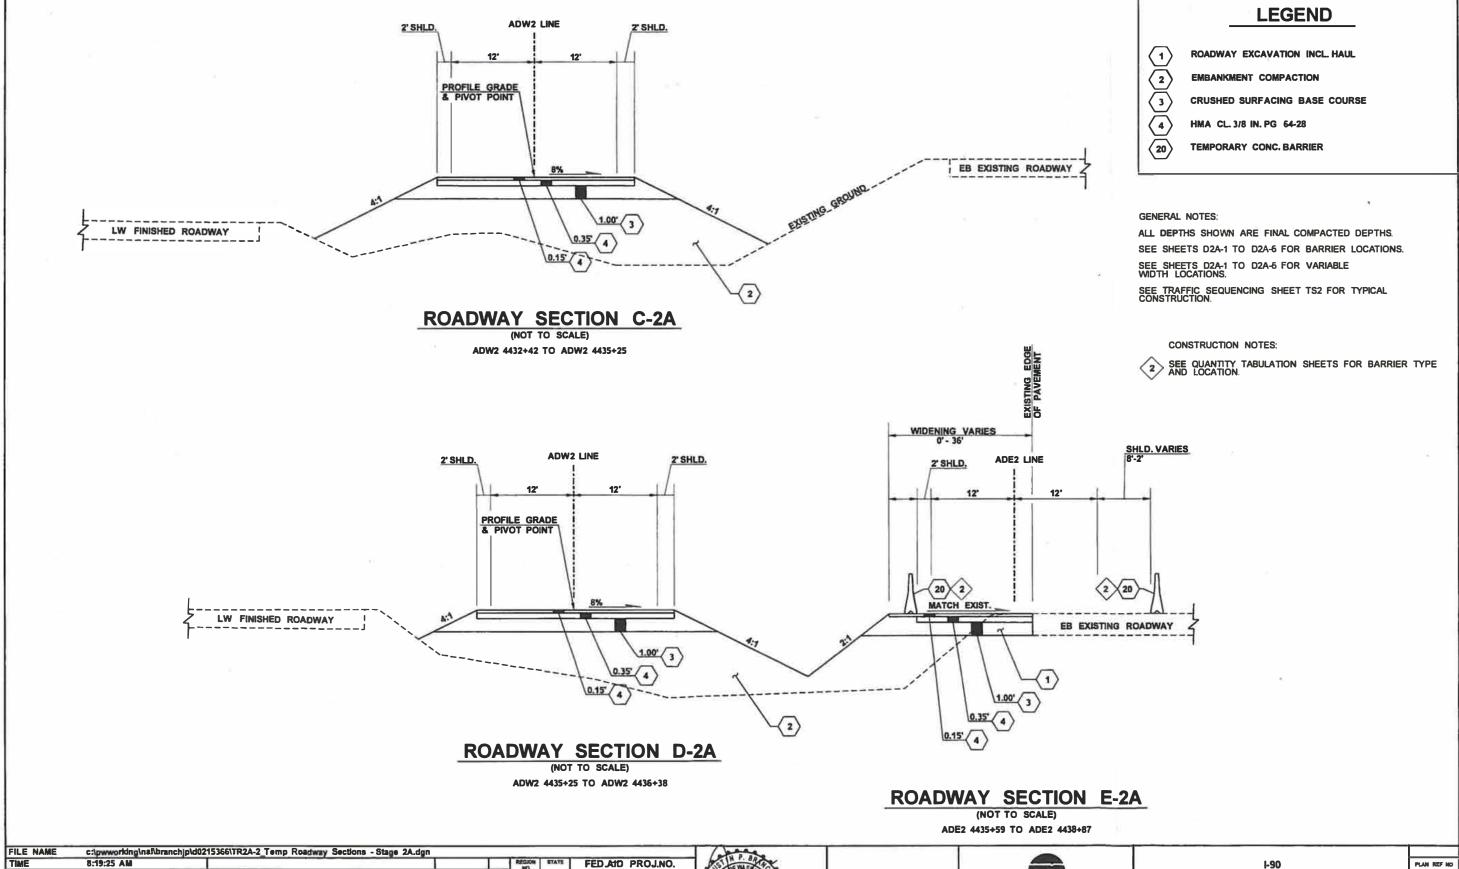

FILE NAME	c:\pwworking\naf\branchjp\c	i0215366\TR2A-2_Temp_Roadway_Sections - Stage_2A.dgi	n					
TIME	8:19:25 AM				REGION NO.	STATE	FED.AID PROJ.NO.	1 1
DATE	6/5/2015			It		WASH		14
PLOTTED BY	branchjp	Y	- No	1 (	10	WASH		141
DESIGNED BY	J. BRANCH		1	1 1		uiiDi		11-
ENTERED BY	J. RAMIREZ		1	1 1	14	Y015		1
CHECKED BY	J. TAYLOR		1	1 1	CONTI	RACT NO.	LOCATION NO.	1
PROJ. ENGR.	S. GOLBEK	i	1	T		- 1		1
REGIONAL ADM	. D. WHITEHOUSE	REVISION	DATE	I BY		- 1		1





Washington State Department of Transportation KEECHELUS DAM TO STAMPEDE PASS PHASE 2A - ADD LANES/BUILD WILDLIFE BRIDGES

**TR2A-2** 

TEMP. ROADWAY SECTIONS - STAGE 2A

## **LEGEND**

ROADWAY EXCAVATION INCL HAUL

EMBANKMENT COMPACTION

CRUSHED SURFACING BASE COURSE

HMA CL. 3/8 IN. PG 64-28

20 TEMPORARY CONC. BARRIER

#### GENERAL NOTES:

4

ALL DEPTHS SHOWN ARE FINAL COMPACTED DEPTHS. SEE SHEETS D2A-1 TO D2A-6 FOR BARRIER LOCATIONS. SEE SHEETS D2A-1 TO D2A-6 FOR VARIABLE WIDTH LOCATIONS. SEE TRAFFIC SEQUENCING SHEET TS2 FOR TYPICAL CONSTRUCTION.

EB EXISTING ROADWAY

CONSTRUCTION NOTES:

2 SEE QUANTITY TABULATION SHEETS FOR BARRIER TYPE AND LOCATION.

## **ROADWAY SECTION G-2A**

ADE2 LINE 2'SHLD.

12'

2' SHLD.

(NOT TO SCALE) ADE2 4438+87 TO ADE2 4440+50

FILE NAME	c:\pwworking\naf\branchjp\d0215366	NTR2A-3 Temp Roadway Sections - Stage	2A.dgn				
TIME	2:34:10 PM				REGION NO.	STATE	FED.AID PROJ.NO
DATE	6/2/2015					DAVAGUE	
PLOTTED BY	branchjp				10	WASH	
DESIGNED BY	J. BRANCH				108 N	AUMBER	
ENTERED BY	J. RAMIREZ			1	14	Y015	
CHECKED BY	J. TAYLOR			1	cosm	MET NO.	LOCATION NO.
PROJ. ENGR.	S. GOLBEK			1			
REGIONAL ADM.	D. WHITEHOUSE	REVISION	DATE	BY			

WIDENING VARIES

MATCH EXIST.

**ROADWAY SECTION F-2A** (NOT TO SCALE) ADW2 4436+38 TO ADW2 4440+32

Z SHLD.

ADW2 LINE

PROFILE GRADE

2' SHLD.

LW FINISHED ROADWAY






1-90												
KEECHELUS DAM TO STAMPEDE PASS PHASE												
2A - ADD	LANES/E	BUILD WILDLE	FE BRIDGES									

DITET

TR2A-3

TEMP. ROADWAY SECTIONS - STAGE 2A

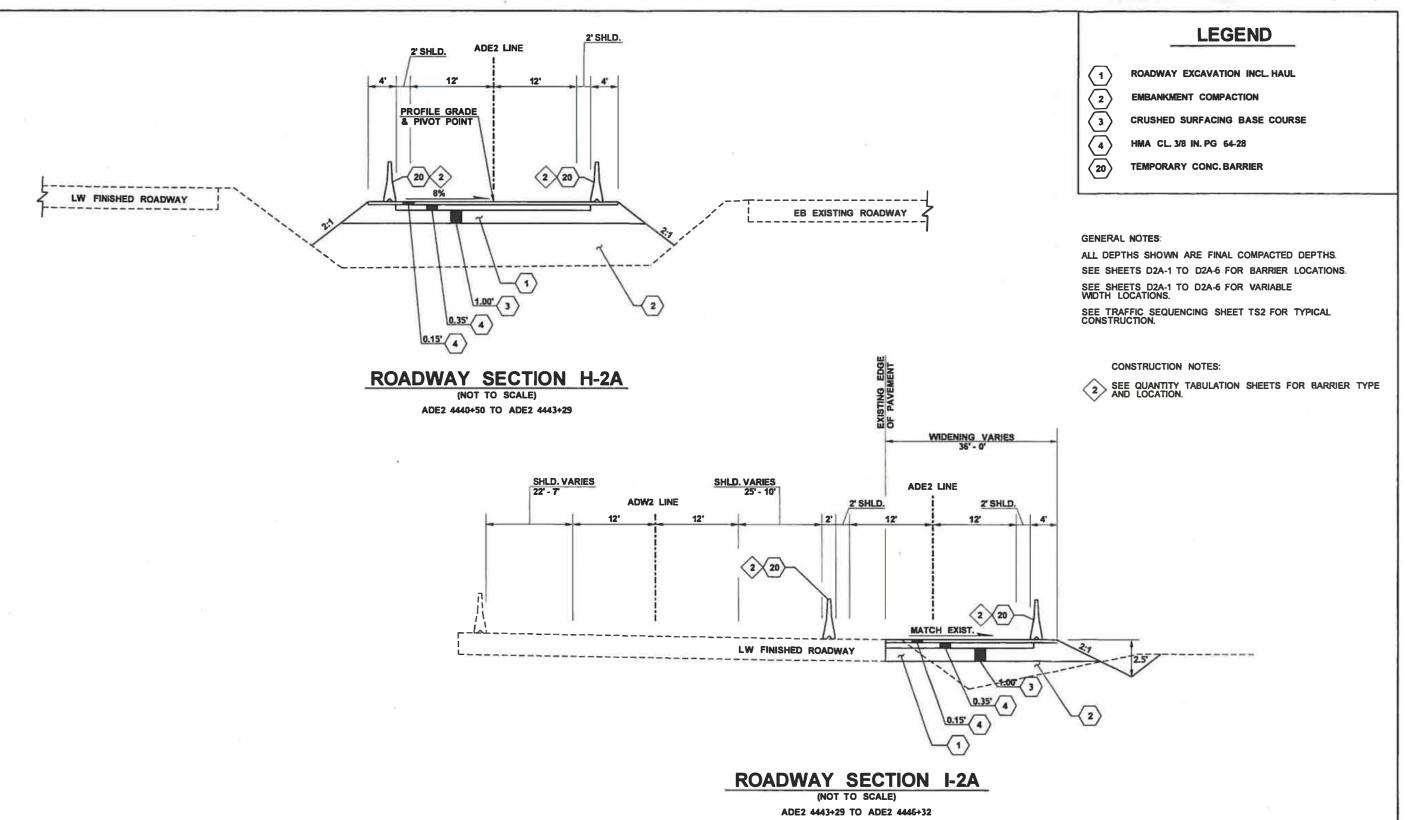

FILE NAME	c:\pwworking\naf\branchjp\d021536	SITR2A-4_Temp Roadway Sections - Stage	2A.dgn			J	
TIME	8:37:33 AM			1 10	NO.	STATE.	FED.AID PROJ.NO.
DATE	6/22/2015			$\Box$		TALL CL	
PLOTTED BY	branchjp		144		10	WASH	
DESIGNED BY	J. BRANCH				JOS 1	NUMBER .	
ENTERED BY	J. RAMIREZ		1		14	Y015	
CHECKED BY	J. TAYLOR			1	CONT	TUACT NO.	LOCATION NO.
PROJ. ENGR.	S. GOLBEK		1	i i			
REGIONAL ADM	. D. WHITEHOUSE	REVISION	DATE	İBYİ		- 1	







1-90												
KEECHELUS	DAM	то	ST	AMPEDE	PASS	PHASE						
2A - ADD	LANE	s/BU	IILD	WILDLI	E BRI	DGES						

TEMP. ROADWAY SECTIONS - STAGE 2A

TR2A-4

PLAN REF NO

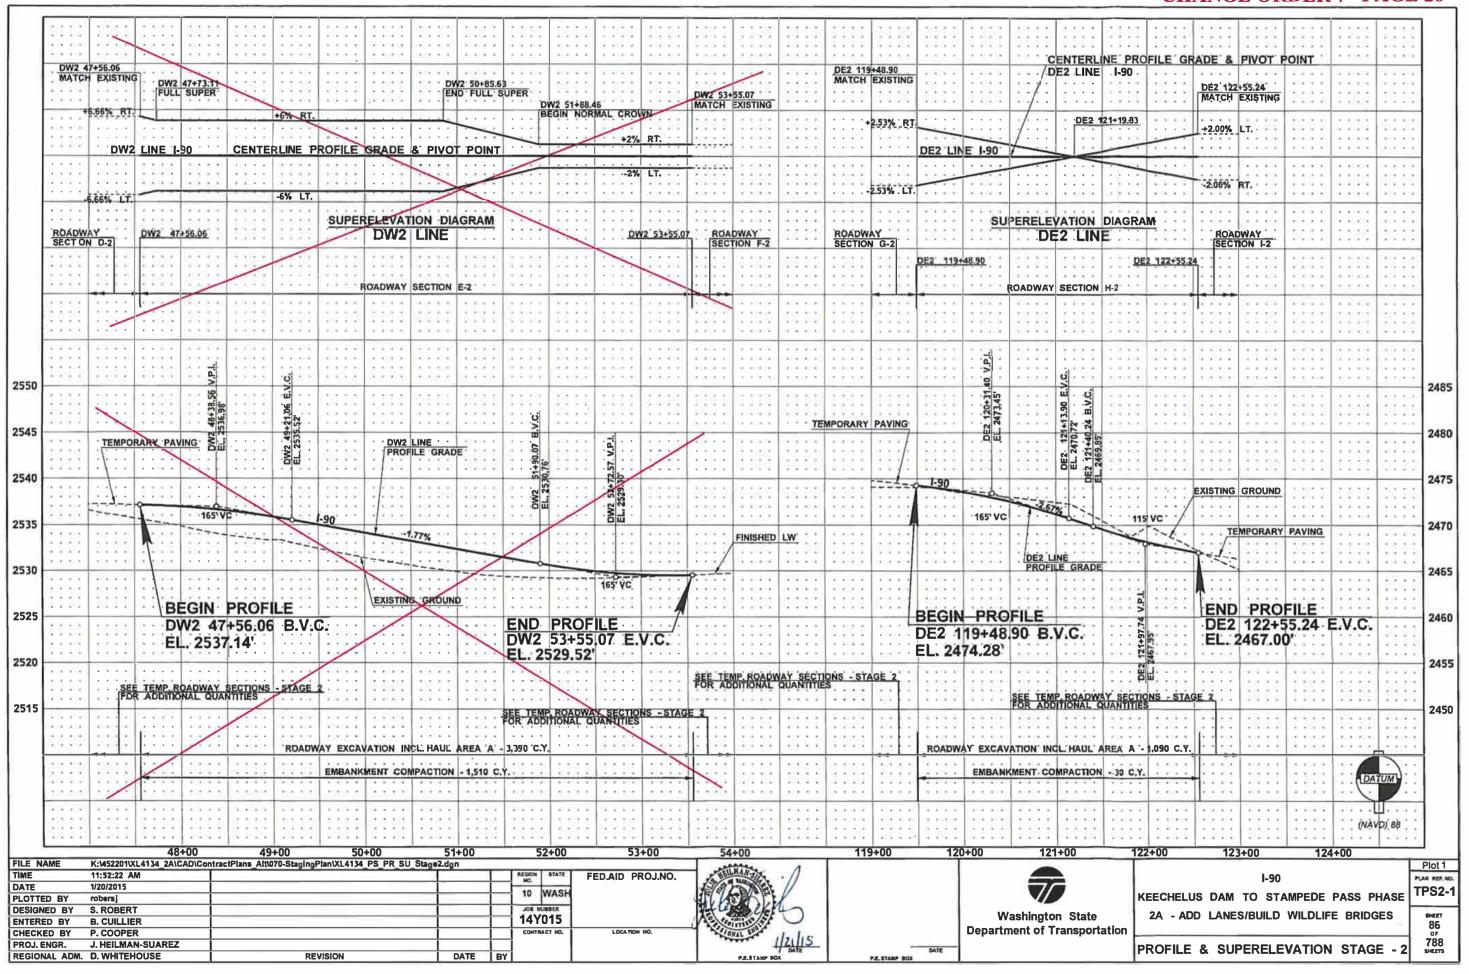

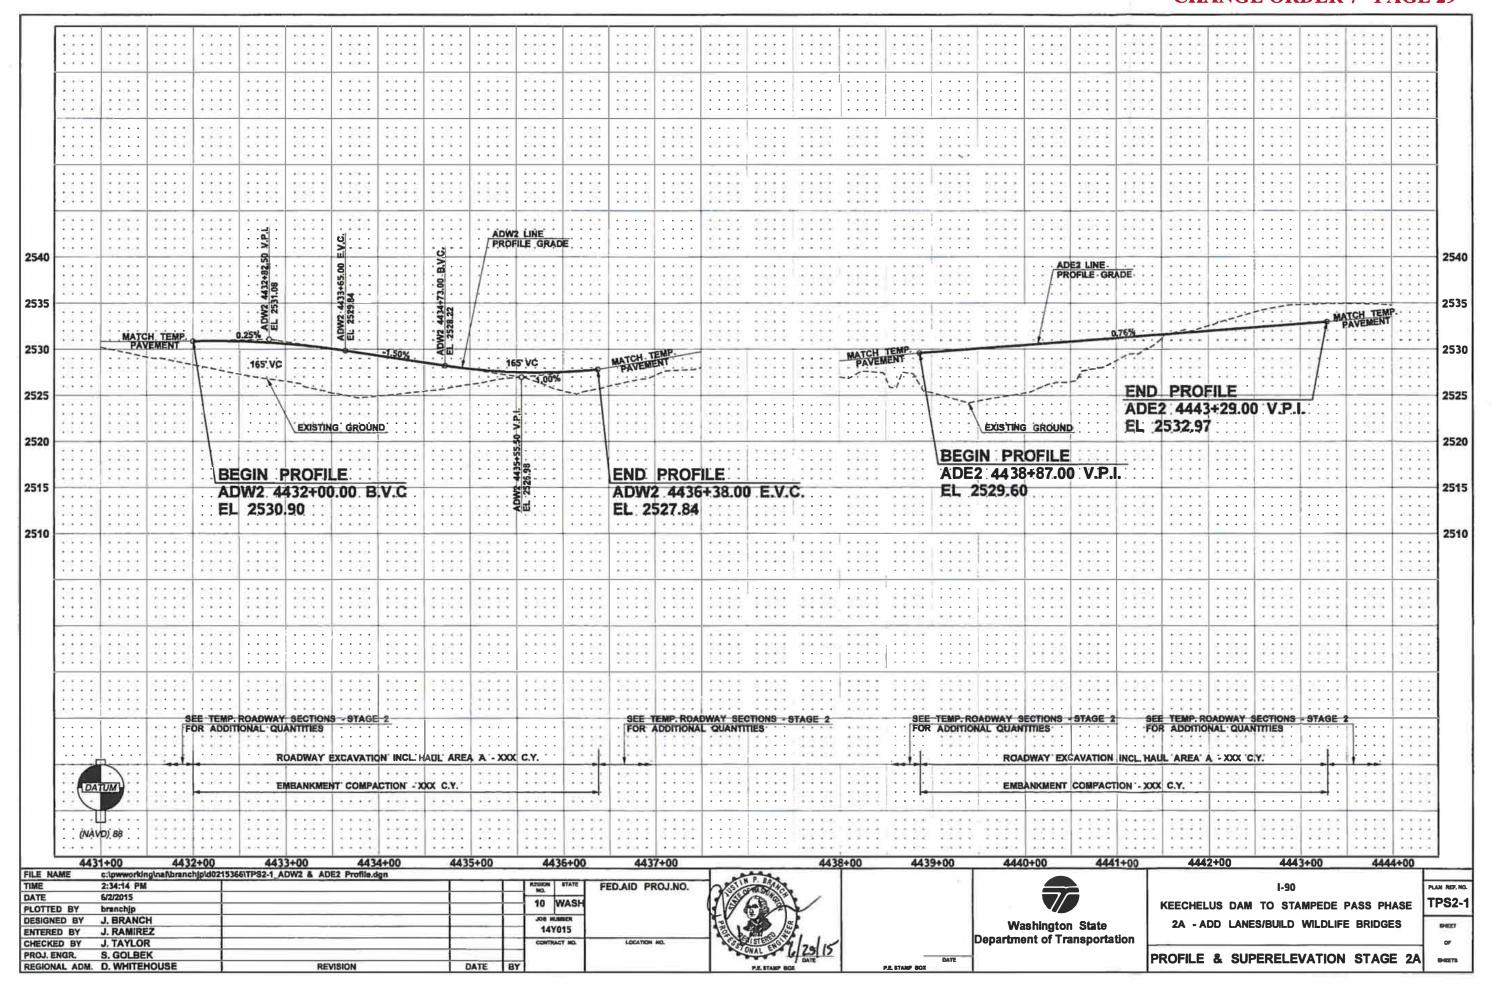


						QU	ANT	ITY T	ABU	LATI	ON -	STA	GE 2					
NOTE: THE FIRST NUMBER OF THE "CODE" BEL REFERS TO THE SHEET NO. OR THE SHE		BARRIER*	•,			31 - 8	TRANSITION			BARRIER*		吕		DE	TOR	ТОВ		GENERAL NOTES:
REFERENCE NO. SHOWING THE CONSTRUCTION FEATURE.		CONG. BAR	GUARDRAIL*	GUARDRAIL	Э	IRAIL TYPE	4.5			CONC	IMPACT IR*	RIGID GUIDE : W)*		RIGID GUIDE : Y)*	BARRIER DELINEATOR E W)*	DELINEATOR	L NOTES	
THE SECOND NUMBER REFERS TO THE CONSTRUCTION FEATURE FOUND ON THE SHEET.	HAT	ZEMOVING C	REMOVING G	REMOVING G ANCHOR*		BEAM GUARDRAIL FT. LONG POST*	BEAM GUARDRA SECTION TYPE 2	SARRIER GAP		TEMPORARY	RESETTING IM ATTENUATOR	TEMPORARY F POSTS (TYPE		TEMPORARY F	LDS BARRIER (TYPE W)*	LOS BARRIER ( (TYPE Y)*	SEE GENERAL	
CODE   LOCATION ✓ \ UNIT OF MEASU	IRE ≻	L.F.	L.F.	EACH		L.F.	EACH	EACH		L.F.	EACH	EACH		EACH	EACH	EACH	ų,	
DW2 7+08 - DW2 129+06 DE2 7+15 - DE2 133+33												15 16		5			5	1. TEMPORARY IMPACT ATTENUATOR SHALL BE ONE OF THE FOLLOWING: ABSORB 350, TRITON CET, OR TRACC AND SHALL INCLUDE SIGN W12-
60+08.51 (14)										6208								501.
D2-1 1 DW2 10+00 (14' LT) DW2 55+85 (3 D2-1 2 DW2 10+00 (13' PT) - DW2 124+32 ( D2-1 3 DE2 14+32 (14' PT) - DE2 19+02 (14	18' RT)							30 -154-82		44,57.5 -11037.5 -437.5	1				6	<del>1990-188</del>	1, 3, 4, 5 1, 4, 5	2. THIS BARRIER SHALL BE ANCHORED INTO HMA STA. DE2 30+14 TO STA. DE2 53+72.
D2-1 4 DE2 12+10 (19' RT) - DE2 21+52 (69 D2-1 5 DE2 11+63 (18' RT) - DE2 12+23 (14'	)' RT)		970				1										6	3. SEE SHEET TDE3 FOR TEMPORARYGLARE SCREEN DETAIL. SEE SPECIAL PROVISION CONCRETE BARRIER.
D2-1 6 DE2 12+10 (14' RT) - DE2 14+62 (14'	RT)							4		237.5				I.	4		4,5	
D2-2 1 DE2 22+54 (73' RT) - DE2 35+08 (94	(RT)		1230															4. SEE SHEETTDE4 FOR TEMP. CONC. BARRIER DETAIL.
D2-2 2 DE2 19-02 (14' RT) - DE2 30-14 (10' D2-2 3) DE2 30-14 (14' RT) - DE2 50-72 (16'	RT)									2075					24 50		2, 4, 5	
D2-3 1 DE2 35+74 (93' RT) - DE2 42+35 (95	S' RT)		700							2010					- 30		2, 4, 0	5. SEE SPECIAL PROVISION "GUIDE POSTS."  6. TYPE B CONNECTION TO CONCRETE BARRIER
D2-3 2 DE2 43+00 (93' RT) - DE2 55+46 (15			1280					-										REQUIRED.
D2-4 1 DE2 53+72(18' RT) - DE2 61+11 (18' I D2-5 1 DE2 56+13 (159' RT) - DE2 61+51 (2			540	1 1											10		5	THIS ITEM APPEARS ON MULTIPLE QUANTITY
D2-5 2 DE2 60+99 (19' RT) - DE2 65+22 (19	(RT)					312.5	2										6	TABULATION OR STRUCTURE NOTE SHEETS. SEE SHEETS SNQT1 - SNQT2 FOR PROJECT TOTALS.
D2-5 3 DE2 63+96 (221' RT) - DE2 70+56 (1 D2-5 4 DE2 65+07 (18' RT) - DE2 66+20 (18'			660	1	1										2		5	I SHEETS SINGTT - SINGTZ FOR PROJECT TOTALS.
D2-5 5 DE2 68+58 (18' RT) - DE2 73+58 (18'						l 1								-	7		5	
D2-6 1 DE2 73+44 (19' RT) - DE2 89+87 (19	rRT)					1525	2										6	
D2-6 2 DE2 78+58 (151' RT) - DE2 79+22 (1	38' RT)	120	60															
D2-7 1 DE2 87+72 (137' RT) - DE2 98+51 (2	244' RT)		1090	1														
D2-7 2 DE2 89+72 (18' RT) - DE2 92+10 (18'										-					5		5	
D2-7 3 DE2 94+02 (18' RT) - DE2 96+56 (18' D2-8 1 DE2 98+81 (18' RT) - DE2 103+62 (18'															7	l I	5	-
D2-9 1 DE2 121+01 (108' RT) - DE2 128+58			760	1														
				1														
					1												-	1
i												i		1.1				j
																		1
				1	l							1			l	l		-
i i					i							i						
																		-
SHEE	T TOTAL	120	7290	1 3	1	1837.5	5	190 86		6446 <del>18625</del>	<del>2</del> 1	l 31		5	   <del>-213-</del> 39	990 188	al .	1
PROJEC			7290	3	i	1837.5	5	190-86		18525	21		i	5	<del>210</del> 39		8	1
						REGION NO.	STATE	FED. AID	PROJ. NO.	6446								I-90 OS2-
DESIGNED BY S. ROBERT						10	WASH							Jachinat e-	State			I-90 CLUS DAM TO STAMPEDE PASS PHASE DD LANES / BUILD WILDLIFE BRIDGES SHEE
CHECKED BY L. HUCK PROJ. ENGR. J. HEILMAN-SUAREZ		3				14Y								epartment	State of Transpo	ortation	-	74 OF
REGION ADM.  D. WHITEHOUSE   DATE	DATE		REVISION		BY	CONTRA	ACT NO.											QUANTITY TABULATION - STAGE 2 788 SHEET

					QU	ANT	ITY T	ABU	LAT	ION -	STA	GE 2					
								7100									
NOTE: THE FIRST NUMBER OF THE "CODE" BELOW REFERS TO THE SHEET NO. OR THE SHEET REFERENCE NO. SHOWING THE CONSTRUCTION FEATURE.  THE SECOND NUMBER REFERS TO THE CONSTRUCTION FEATURE FOUND ON THAT SHEET.	NOW POLE*	TEMPORARY PAVEMENT MARKING-LONG DURATION	EMPORARY GLARE SCREEN*													SEE GENERAL NOTES	GENERAL NOTES:
CODE   LOCATION Y \ UNIT OF MEASURE >	EACH	L.F.	L.F.													0)	
DW2 7+08 - DW2 129+06	196	-30000														5	TEMPORARY IMPACT ATTENUATOR SHALL BE
DE2 7+15 - DE2 133+33	253	<del>-75710-</del>														5	ONE OF THE FOLLOWING: ABSORB 350, TRITON
20.00.21.4.4																	CET, OR TRACC AND SHALL INCLUDE SIGN W12- 501.
60+08.51 (14' RT)									V-							1.0	ļ
2-1 1 DW2 10+00 (14' LT) DW2 55+95 (30' LT) 2-1 2 DW2 10+00 (13' FH) - DW2 124+32 (18' RT)			11030	6208										-		4,5	2. THIS BARRIER SHALL BE ANCHORED INTO HM
2-1 3 DE2 14+02 (14 RT) - DE2 19+02 (14 RT)			44000													1, 3, 4, 5	STA. DE2 30+14 TO STA. DE2 53+72.
22-1 3 DE2 14+02 (14 HT) - DE2 15+02 (14 HT) 12-1 4 DE2 12+10 (19' RT) - DE2 21+52 (69' RT)																1,7,0	2 000 0000 TO TO TO TO TO TO TO TO TO TO TO TO TO
02-1 5 DE2 11+63 (18' RT) - DE2 12+23 (14' RT)	1															6	3. SEE SHEET TDE3 FOR TEMPORARYGLARE SCREEN DETAIL. SEE SPECIAL PROVISION
	1 1									i							"CONCRETE BARRIER."
2-1 6 DE2 12+10 (14' RT) - DE2 14+62 (14' RT)	1							-			i					4, 5	1
2-2 1 DE2 22+54 (73' RT) - DE2 35+08 (94' RT)		i i			i i	i	( - I			İ	i						4. SEE SHEET TDE4 FOR TEMP. CONC. BARRIER
2 2 DE2 10+02 (14" RT) DE2 30+14 (18" RT)												-				-5-	DETAIL.
2 2 3 DE2 30+14 (14' RT) DE2 53+72 (18' RT)	_															2, 4, 5	5. SEE SPECIAL PROVISION "GUIDE POSTS."
2-3 1 DE2 35+74 (93' RT) - DE2 42+35 (95' RT)																	5. SEE SPECIAL PROVISION GUIDE POSTS.
			<u> </u>														6. TYPE B CONNECTION TO CONCRETE BARRIER
2-3 2 DE2 43+00 (93' RT) - DE2 55+46 (151' RT)																	REQUIRED.
2-4 1 DE2 53+72(18' RT) - DE2 61+11 (18' RT)																5	
2-5 1 DE2 56+13 (159' RT) - DE2 61+51 (212' RT)																	* THIS ITEM APPEARS ON MULTIPLE QUANTITY
02-5 2 DE2 60+99 (19' RT) - DE2 65+22 (19' RT)																6	TABULATION OR STRUCTURE NOTE SHEETS. SE SHEETS SNQT1 - SNQT2 FOR PROJECT TOTALS.
02-5 3 DE2 63+96 (221 RT) - DE2 70+56 (158 RT)	-		ē.													5	i
2-5 4 DE2 65+07 (18' RT) - DE2 66+20 (18' RT) 2-5 5 DE2 68+58 (18' RT) - DE2 73+58 (18' RT)	-		2							1						5	1
12-6 1 DE2 73+44 (19' RT) - DE2 89+87 (19' RT)					-				l	1	-	1				6	-
2-6 2 DE2 78+58 (151' RT) - DE2 79+22 (138' RT)					1					1	1					1	1
2-0 2 0 12 7 0 100 (131 111) - 0 22 7 3 7 22 (100 111)	1	i			1					<del>                                     </del>			-			i	1
2-7 1 DE2 87+72 (137' RT) - DE2 98+51 (244' RT)	i	i i			i					i	i	i					i
2-7 2 DE2 89+72 (18' RT) - DE2 92+10 (18' RT)		i i								i	i					5	i
2-7 3 DE2 94+02 (18' RT) - DE2 96+56 (18' RT)		i i			i				İ		i					5	Ī
2-8 1 DE2 98+81 (18' RT) - DE2 103+62 (18' RT)				<u> </u>							1					5	]
2-9 1 DE2 121+01 (108' RT) - DE2 128+58 (35' RT	)						j			t					ý.		]
1							0										_
																	j
	1																1
	1				1					<u> </u>	ļ			- 4			4
	1			I.			į.		<u> </u>	1	1						4
1	A						i i		-	-	1						1
	1			1					1	-	1						- ·
	i			1		7			<del>                                     </del>	1	i	i					
<u>i</u>			6208						1		ì						1
SHEET TOTA	LI 449	112310	11030	ì					i	i –	i —	i		1		i	1
PROJECT TOTAL		112310		i					i	i	i	i					
		· · · · · · · · · · · · · · · · · · ·	6208		REGION NO.	STATE	FED. AID	PROJ. NO.			to a						
ESIGNED BY S. ROBERT NTERED BY B. CUILLIER					10	WASH							Vashington	State		1	I-90  CLUS DAM TO STAMPEDE PASS PHASE  DD LANES / BUILD WILDLIFE BRIDGES  SHI
HECKED BY L. HUCK	11					UMBER	1						Department	State of Transpo	rtation		7
ROJ. ENGR. J. HEILMAN-SUAREZ						<b>/</b> 015											0
REGION ADM. D. WHITEHOUSE					CONTR	ACT NO.						*					QUANTITY TABULATION - STAGE 2 78
j j date i date	4	REVISION		BY	1				1			l .					SHE

						QUA	ITNA	TY T	ABUL	_ATI	- NC	STAC	GE 2/	Α				
REFER REFER CONST	RST NUMBER OF THE "CODE" BELOW S TO THE SHEET NO. OR THE SHEET ENCE NO. SHOWING THE RUCTION FEATURE. COND NUMBER REFERS TO THE RUCTION FEATURE FOUND ON THAT	REMOVING CONC. BARRIER*	REMOVING GUARDRAIL*	REMOVING GUARDRAIL ANCHOR*		BEAM GUARDRAIL TYPE 31 - 8 FT. LONG POST⁴	WEATHERING ST. BEAM GUARDRAIL TYPE 31*	BEAM GUARDRAIL TYPE 31		BEAM GUARDRAIL TRANSITION SECTION TYPE 21*	BEAM GUARDRAIL TYPE 31 NON-FLARED TERMINAL	BEAM GUARDRAIL ANCHOR TYPE 10		BARRIER GAP*	TEMPORARY CONC. BARRIER*	TEMPORARY IMPACT ATTENUATOR	SEE GENERAL NOTES	GENERAL NOTES:
D2A-1 1 A	LOCATION ▼ \ UNIT OF MEASURE ➤ ADW2 4428+10 - DW2 69+00 ADE2 4430+09.69 - DE2 69+16.53 ADW2 4428+10 (14' LT) - ADW2 4429+50 (14' LT) ADE2 4430+09.69 (13' LT) - DE2 69+16.53 (14' LT) ADE2 4435+59 (22' RT) - LW 1476+50 (28' RT)			EACH						EACH	EACH	EACH		108 111	140 6023 4026	EACH	2, 3, 4 2, 3, 4 2, 3, 4 2, 3, 4	1. TEMPORARY IMPACT ATTENUATOR SHALL BE ONE OF THE FOLLOWING: ABSORB 350, TRITON CET, OR TRACC AND SHALL INCLUDE SIGN W12-501.  2. SEE SHEET TDE3 FOR TEMPORARY GLARE SCREEN DETAIL. SEE SPECIAL PROVISION "CONCRETE BARRIER."  3. SEE SHEET TDE-4 FOR TEMP. CONC. BARRIER DETAIL.  4. SEE SPECIAL PROVISION "GUIDE POSTS."  * THIS ITEM APPEARS ON MULTIPLE QUANTITY TABULATION OR STRUCTURE NOTE SHEETS. SEE SHEETS SNQT1 - SNQT2 FOR PROJECT TOTALS.
ENTERE CHECKE PROJ. E	ED BY J. BRANCH D BY M. PANICK D BY A. SCHMIDTMAN NGR. S. GOLBEK ADM. D. WHITEHOUSE DATE DATE		REVISION	1	BY	149	WASH UMBER 7015 ACT NO.	FED. AID	PROJ. NO.		i	i:	<b>%</b>	119 Hashington Department	10189 State of Transpo	ortation	2A - AD	I-90 ELUS DAM TO STAMPEDE PASS PHASE DD LANES / BUILD WILDLIFE BRIDGES OF QUANTITY TABULATION - STAGE 2A SHEET

								QUA	ANTI	TY T	ABUL	ATIO	- NC	STAC	GE 2/	4					
REFE REFE CONS	FIRST NUMBER OF THE "CO RS TO THE SHEET NO. OF RENCE NO. SHOWING THI STRUCTION FEATURE. SECOND NUMBER REFERS STRUCTION FEATURE FOU	R THE SHEET E S TO THE		ESETTING IMPACT TTENUATOR*	TEMPORARY RIGID GUIDE POST (TYPE W)*	TEMPORARY RIGID GUIDE POST (TYPE Y)*		.DS BARRIER DELINEATOR TYPE W)*	LDS BARRIER DELINEATOR (TYPE Y)*	SNOW POLE*		AINT LINE	AINTED STOP LINE		TEMPORARY PAVEMENT MARKING-LONG DURATION*	EMPORARY GLARE SCREEN*			EE GENERAL NOTES	GENERAL NOTES:	
D2A-1 1 D2A-1 2	LOCATION V \ UNIT C ADW2 4428+10 - DW2 69+ ADE2 4430+09.69 - DE2 69 ADW2 4428+10 (14' LT) - ADW ADE2 4430+09.69 (13' LT) - DE ADE2 4435+59 (22' RT) - LV	00 0+16.53 V2 4429+50 (14 E2 69+16.53 (14	4' LT)	EACH	EACH	EACH  I  I  I  I  I  I  I  I  I  I  I  I  I		EACH	260	EACH		L.F.			L.F. 120816 122886	6023			2, 3, 4 2, 3, 4 2, 3, 4 2, 3, 4 1, 2, 3, 4 1, 3, 4 1, 4 1, 4 1, 4 1, 4 1, 4 1, 4 1, 4 1	1. TEMPORARY IMPACT ATTENUATOR SHAONE OF THE FOLLOWING: ABSORB 350, TRUET, OR TRACC AND SHALL INCLUDE SIGN 501.  2. SEE SHEET TDE3 FOR TEMPORARY GLASCREEN DETAIL. SEE SPECIAL PROVISION "CONCRETE BARRIER."  3. SEE SHEETTDE-4 FOR TEMP. CONC. BADETAIL.  4. SEE SPECIAL PROVISION "GUIDE POSTS THIS ITEM APPEARS ON MULTIPLE QUANTABULATION OR STRUCTURE NOTE SHEET SHEETS SNQT1 - SNQT2 FOR PROJECT TO	RITON N W12-  ARE ARRIER  S."  WITTY TS. SEE
		SHEET TO	OTAL			 		87 REGION NO.	260 <b>STATE</b>	       FED. AID	l l PROJ. NO.				243702	6023			1		
ENTER CHECK PROJ.	NED BY J. BRANCH ED BY M. PANICK (ED BY A. SCHMIDTMAN) ENGR. S. GOLBEK							14Y	WASH JMBER 015						<b>*</b> 8	Vashington Jepartment	State of Transpo	rtation	2A - AD	I-90 LUS DAM TO STAMPEDE PASS PHASE D LANES / BUILD WILDLIFE BRIDGES	QS2A- 2 SHEET OF
REGIO	N ADM. D. WHITEHOUSE	DATE D	ATE		REVISION		BY	CONTRA	ACT NO.											UANTITY TABULATION - STAGE 2A	SHEETS

**DETOUR PLAN - STAGE 2A** 

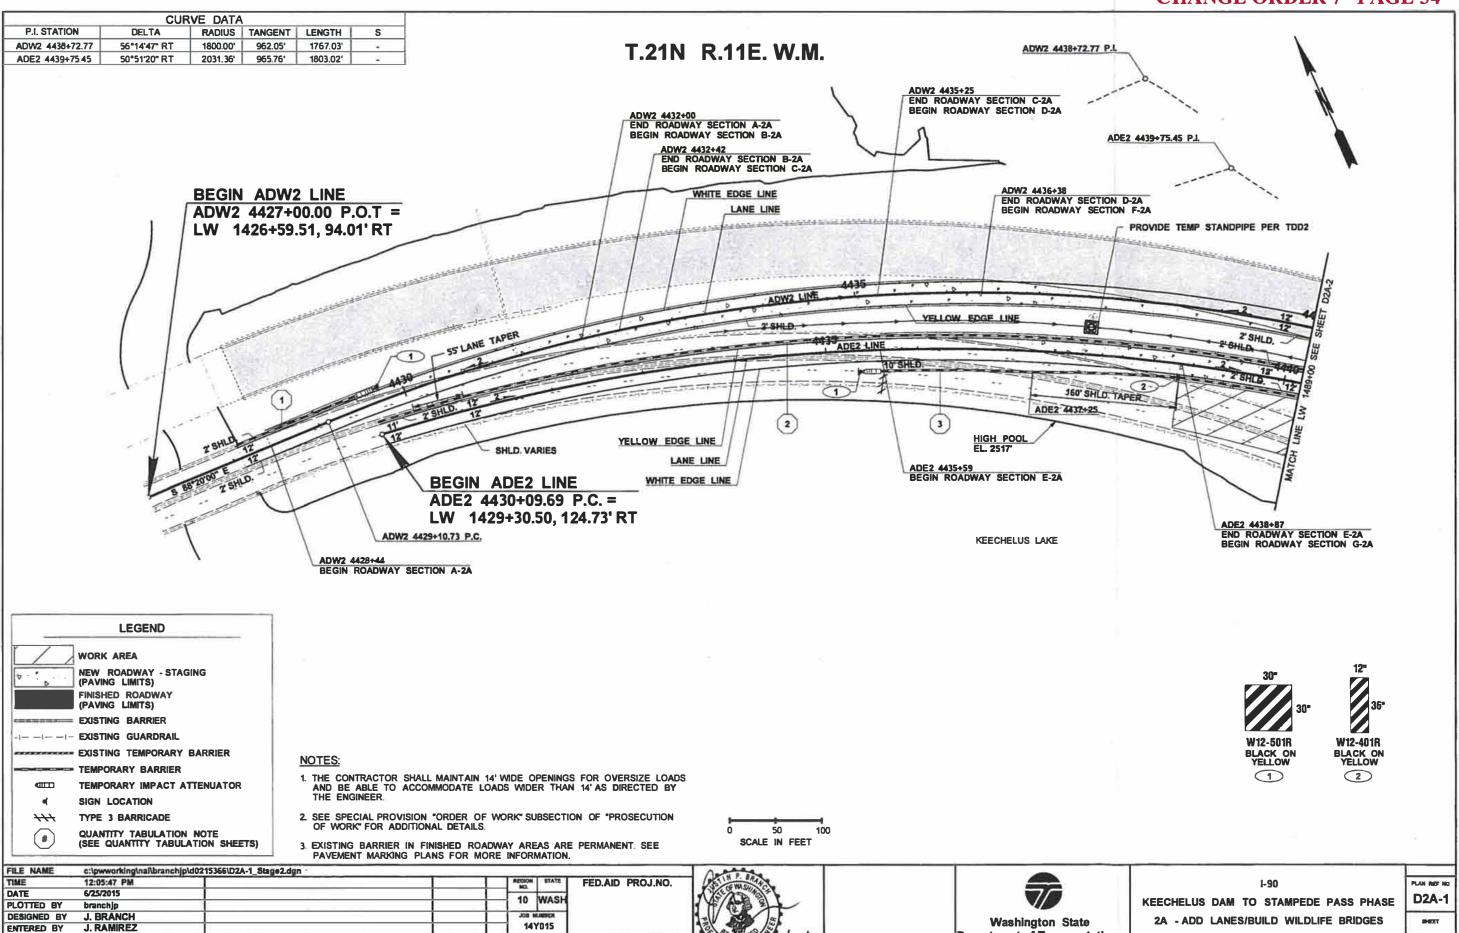

DATE BY

REVISION

CHECKED BY


PROJ. ENGR.

J. TAYLOR S. GOLBEK

REGIONAL ADM. D. WHITEHOUSE

Department of Transportation

**DETOUR PLAN - STAGE 2A** 

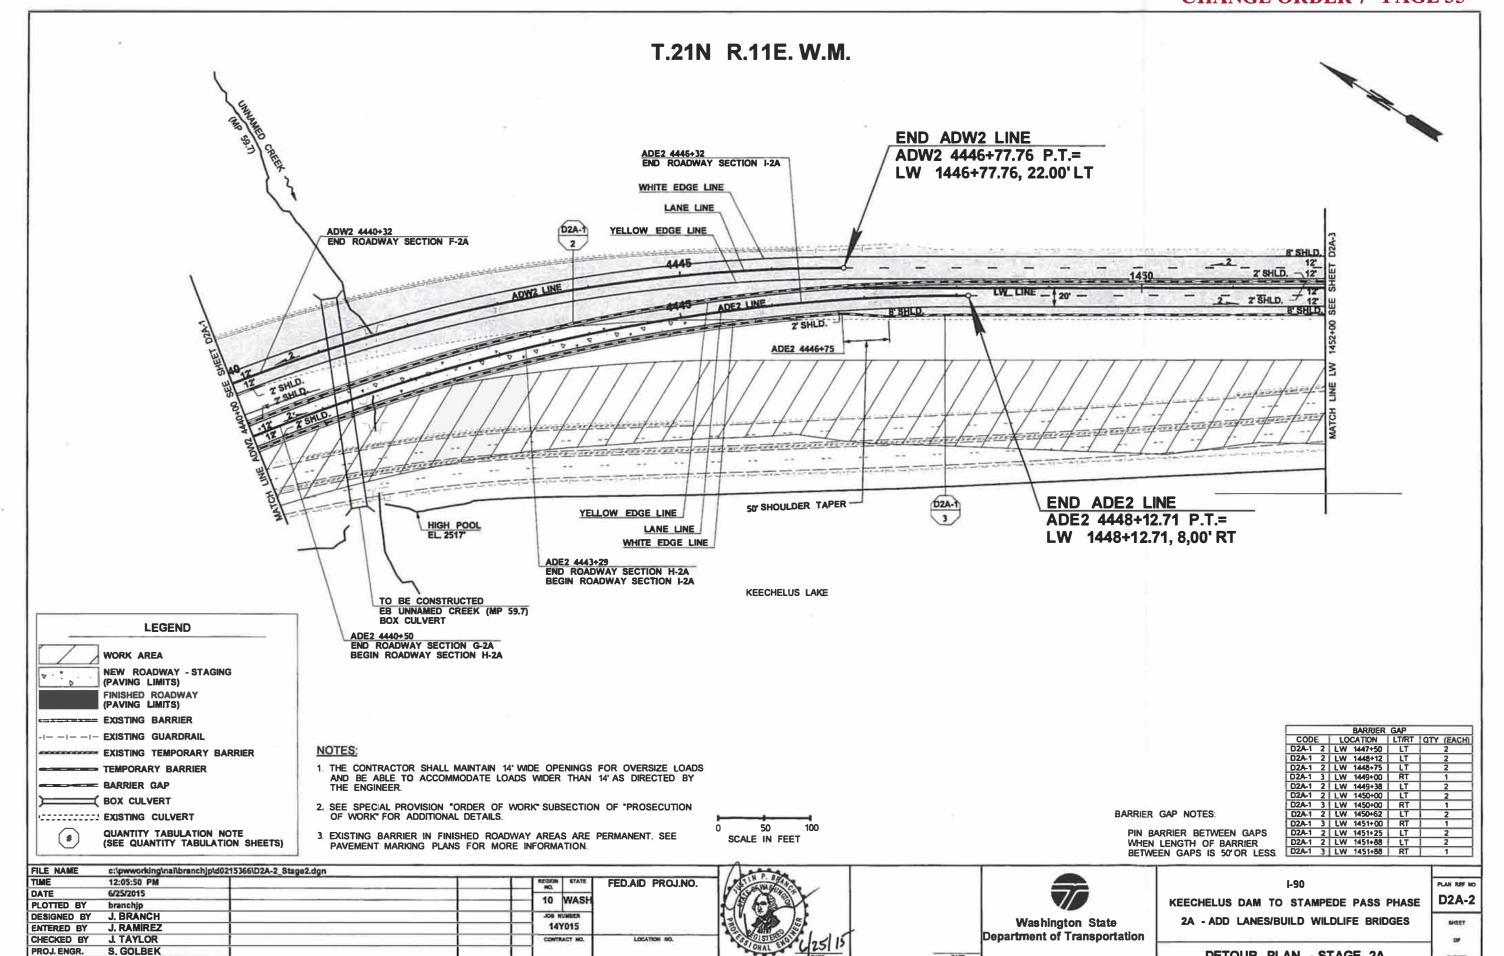

DATE BY


REVISION


DATE

P.E. ETAMP BOX

PROJ. ENGR.

REGIONAL ADM. D. WHITEHOUSE

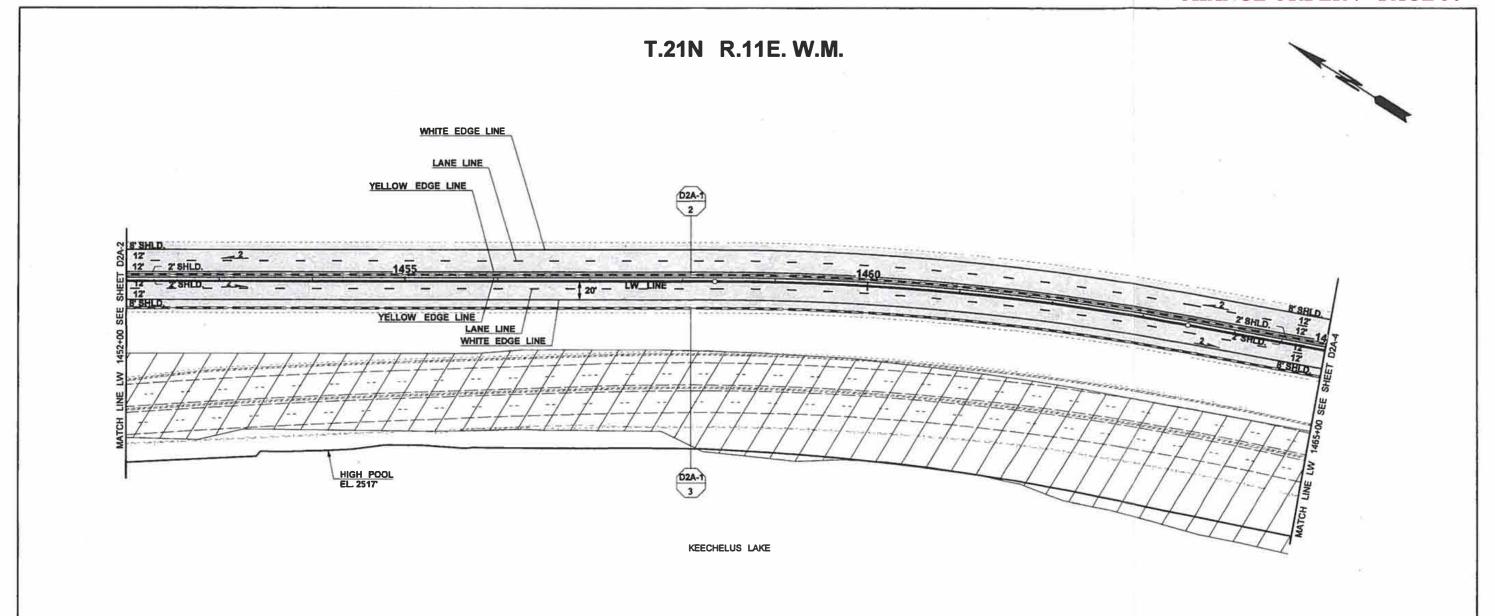

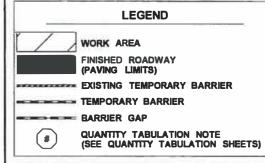

#### NOTES:

- 1. THE CONTRACTOR SHALL MAINTAIN 14' WIDE OPENINGS FOR OVERSIZE LOADS AND BE ABLE TO ACCOMMODATE LOADS WIDER THAN 14' AS DIRECTED BY THE ENGINEER.
- 2. SEE SPECIAL PROVISION "ORDER OF WORK" SUBSECTION OF "PROSECUTION OF WORK" FOR ADDITIONAL DETAILS

-	-	
0	50	100
	SCALE IN F	EET

CODE	LOOKIION	LIMI	I Q I T (EACH)
	LW 1452+50		2
D2A-1 3	LW 1452+50		1
D2A-1 2	LW 1453+12	LT	2
D2A-1 3	LW 1453+12	RT	1
D2A-1 2	LW 1453+75	LT	2
D2A-1 3	LW 1453+75	RT	1 1
D2A-1 2	LW 1454+37	LT	2
D2A-1 3	LW 1454+75	RT	1
D2A-1 2	LW 1455+00	LT	2
D2A-1 2	LW 1455+62	LT	2
D2A-1 2	LW 1456+25	LT	2
D2A-1 2	LW 1456+88	LT	2
D2A-1 2	LW 1458+13	LT	2
D2A-1	LW 1458+13	RT	1
D2A-1 2	LW 1459+13	LT	2
D2A-1 3	LW 1459+13	RT	1 1
D2A-1 2	LW 1460+00	LT	2
	LW 1450+00		1
D2A-1 2	LW 1461+00	LT	2
D2A-1	LW 1452+00	LT	2
	LW 1463+00	LT	2
D2A-1 2	LW 1464+00	LT	2
D24 4 1	I + VAL + ACT LOO	1.7	7

BARRIER GAP NOTES:

PIN BARRIER BETWEEN GAPS WHEN LENGTH OF BARRIER BETWEEN GAPS IS 50'OR LESS.

D2A-1 2	LW 1456+25 I	LI	2
D2A-1 2	LW 1456+88	LT	2
D2A-1 2	LW 1458+13	LT	2
D2A-1 3	LW 1458+13	RT	1
D2A-1 2	LW 1459+13	LT	2
D2A-1 3	LW 1459+13	RT	1
D2A-1 2	LW 1460+00	LT	2
D2A-1 3	LW 1450+00	RT	1
D2A-1 2	LW 1461+00	LT	2
D2A-1 2	LW 1452+00	LT	2
D2A-1 2	LW 1463+00 I	LT	2
D2A-1 2	LW 1464+00	LT	2
D2A-1 2	LW 1465+00	LT	2

FILE NAME	c:\pwworking\nal\branchjp\d0215366	D2A-3_Stage2.dgn					
TIME	12:05:53 PM			Т	REGION	STATE	FED.AID PROJ.NO.
DATE	6/25/2015				-		
PLOTTED BY	branchjp		11	1	10	WASH	
DESIGNED BY	J. BRANCH			1 1	2.6000000	FREMEN	
ENTERED BY	J. RAMIREZ		1	1 1	14	Y015	
CHECKED BY	J. TAYLOR		1		CONTI	24CT HD,	LOCATION NO.
PROJ. ENGR.	S. GOLBEK		1_	1 1	į	- 1	
REGIONAL ADM.	D. WHITEHOUSE	REVISION	DATE	BY			




7/5
Washington State Department of Transportation

			1-20			
KEECHELUS	DAM	то	ST	AMPEDE	PASS	PHASE
2A - ADD	LANE	s/BU	IILD	WILDLI	E BRI	DGES

**DETOUR PLAN - STAGE 2A** 

DEET

D2A-3

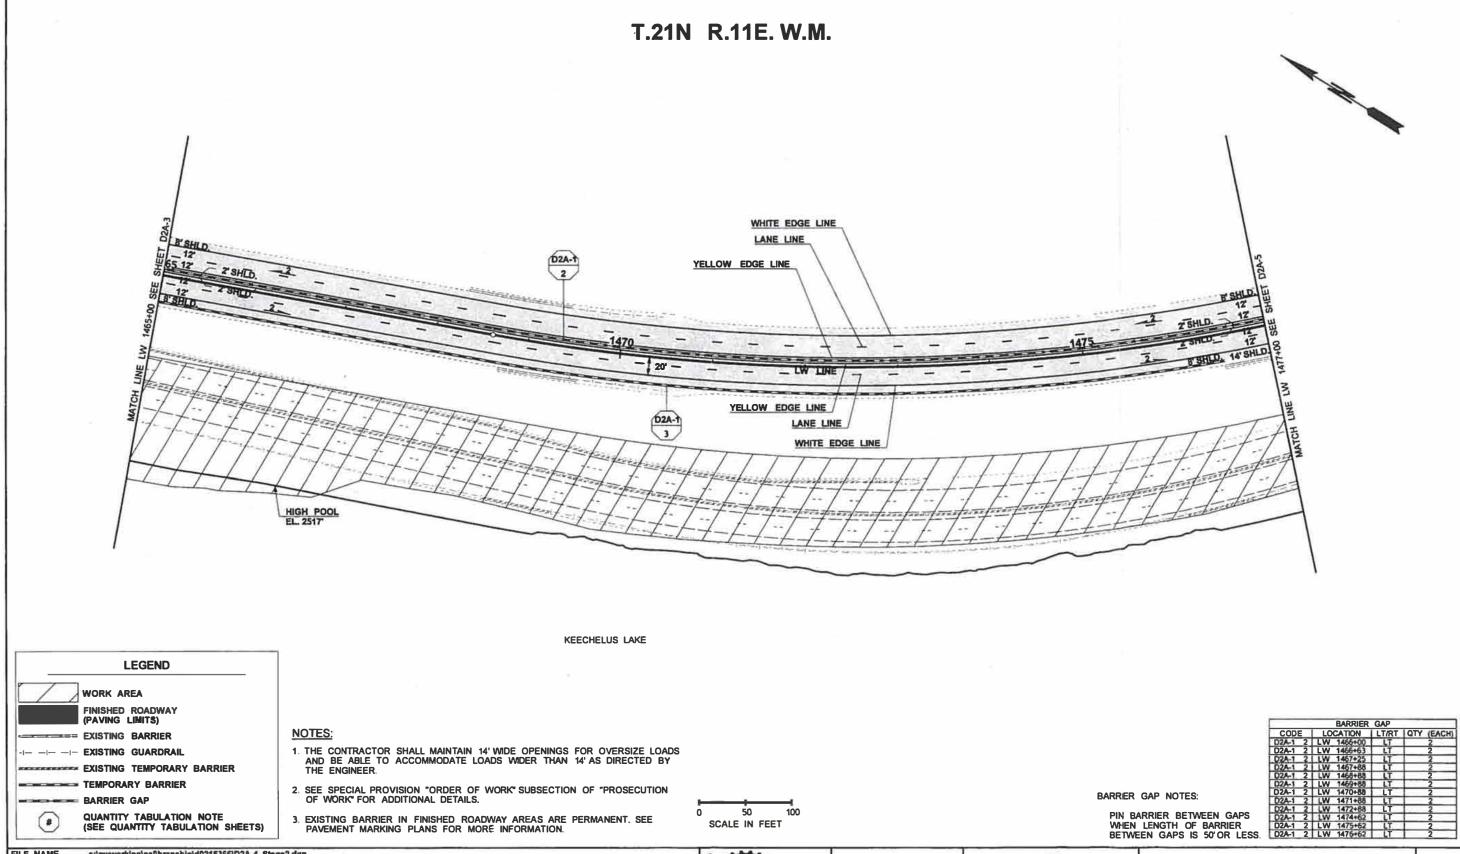

FILE NAME	c:\pwworking\naf\branchjp\d0215366						
TIME	12:05:57 PM				REGION NO.	STATE	FED.AID PROJ.NO.
DATE	6/25/2015		T	l i	1111	WASH	
PLOTTED BY	branchjp				10	MASH	
DESIGNED BY	J. BRANCH		1				
ENTERED BY	J. RAMIREZ				14	Y015	
CHECKED BY	J. TAYLOR				COMT	NACT MO.	LOGATION NO.
PROJ. ENGR.	S. GOLBEK		1	1 1		- 1	
PECIONAL ADM	D WHITEHOUSE I	PEVISION	I DATE	I RY I		- 46	







**I-90** KEECHELUS DAM TO STAMPEDE PASS PHASE 2A - ADD LANES/BUILD WILDLIFE BRIDGES

D2A-4

**DETOUR PLAN - STAGE 2A** 

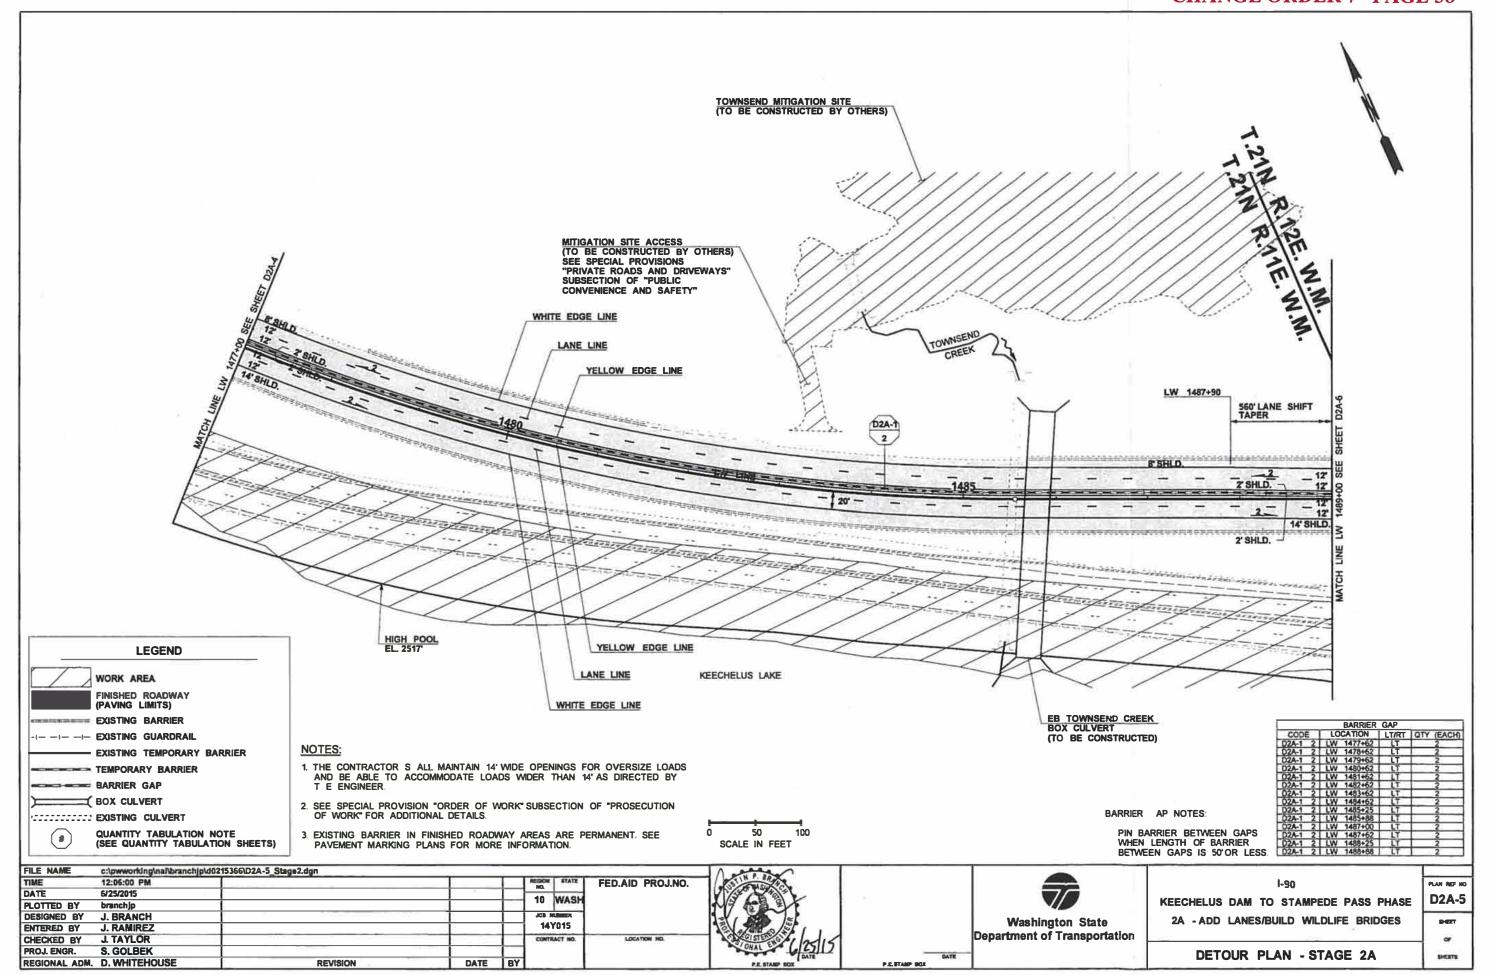

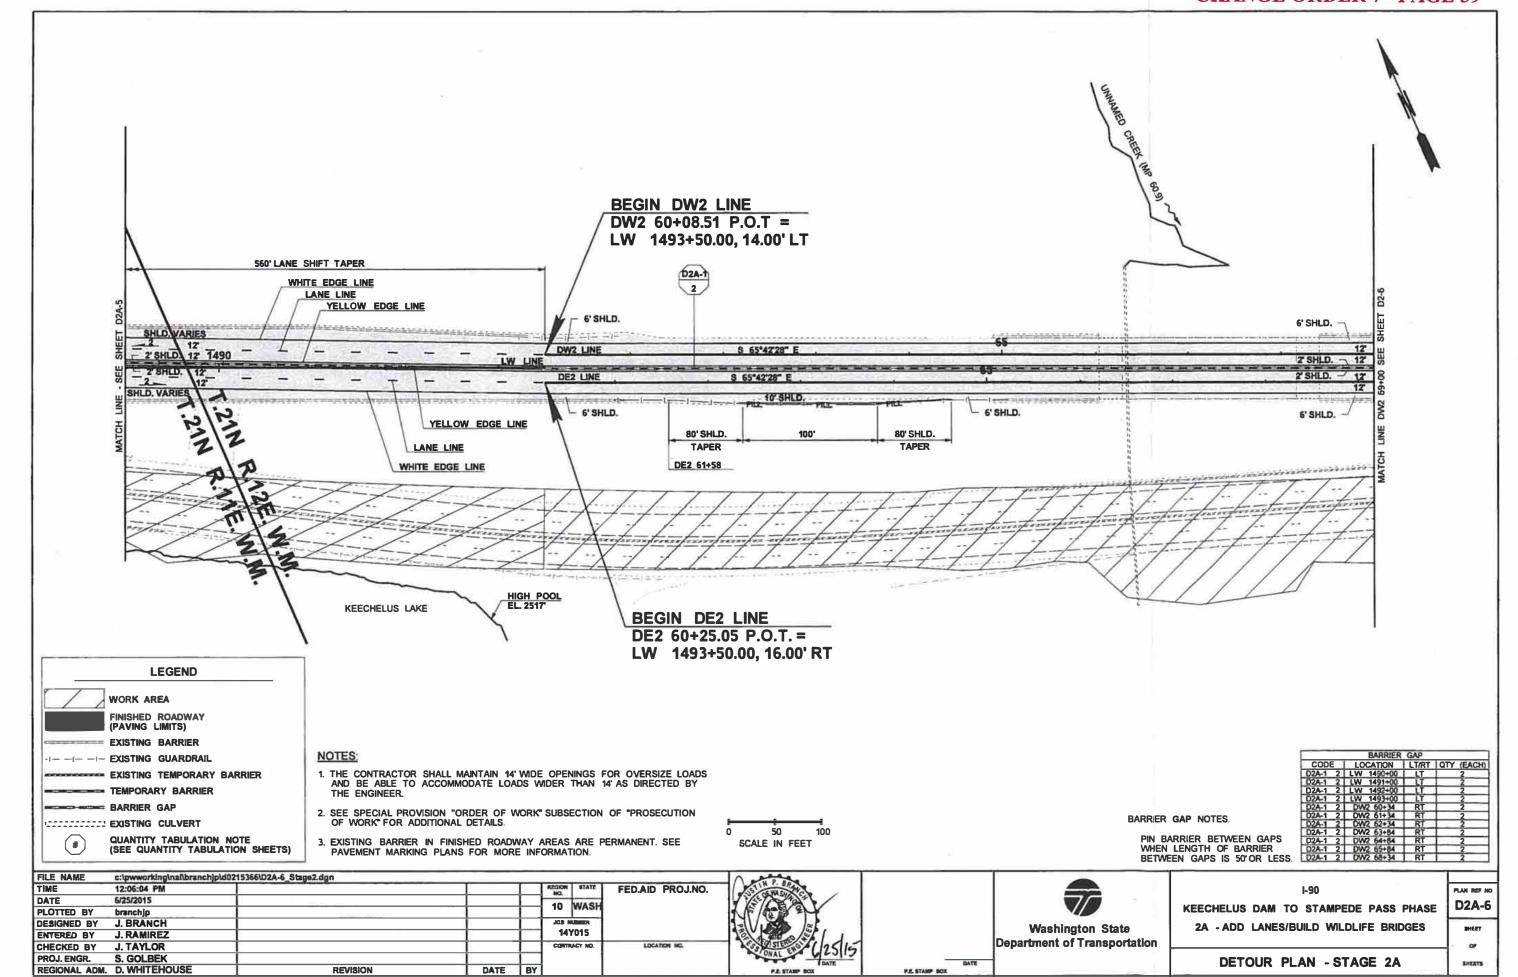

					QU	ANT	ITY 1	TABU	LATI	ON -	STA	GE 3						
NOTE: THE FIRST NUMBER OF THE "CODE" BELOW REFERS TO THE SHEET NO. OR THE SHEET REFERENCE NO. SHOWING THE CONSTRUCTION FEATURE.  THE SECOND NUMBER REFERS TO THE CONSTRUCTION FEATURE FOUND ON THAT SHEET.	REMOVING CONC. BARRIER*	REMOVING GUARDRAIL*	BEAM GUARDRAIL TYPE 31 - 8 FT. LONG POST⁴		BEAM GUARDRAIL TRANSITION SECTION TYPE 21*	BARRIER GAP*	TEMPORARY CONG. BARRIER*		TEMPORARY RIGID GUIDE POST (TYPE W)*	LDS BARRIER DELINEATOR (TYPE W)*	LDS BARRIER DELINEATOR (TYPE Y)*		SNOW POLE*	TEMPORARY PAVEMENT MARKING-LONG DURATION*	TEMPORARY GLARE SCREEN*	SEE GENERAL NOTES	GENERAL NOTES:	
CODE   LOCATION > \ UNIT OF MEASURE >     DW3 22+90 - DW3 145+31     DE3 22+70 - DE3 149+33     D3-1 1 DE3 22+70 (160' RT) - DE3 23+20 (164' RT)	L.F.	L.F.	L.F.		EACH	EACH	L.F.		EACH 6	EACH	EACH		EACH 51	73450 37900	L.F.	5	1. THIS BARRIER SHALL BE ANCHORED INT (STA. DE3 46+60 TO STA. DE3 47+31).	
D3-1 2 DE3 23+20 (164' RT) - DE3 23+83 (167' RT) D3-1 3 DE3 23+83 (167' RT) - DE3 37+51 (146' RT)  D3-1 4 DE3 22+70 (15' RT) DE3 40+52 (18' RT) D3-1 5 DW3 24+40 (22' LT) DW3 47+67 (18' LT)	60	1330	1725		1					75						4, 8	SEE SHEET TDE3 FOR TEMPORARY GLA     SCREEN DETAIL. SEE SPECIAL PROVISION     "CONCRETE BARRIER."      SEE SHEET TDE4 FOR TEMP. CONC. BAI	
D3-1 5 DW2 24+40 (22'LT) DW3 47+67 (18'LT) D3-1 6 DE3 22+70 (13'LT) - DE3 47+31 (14'LT) D3-2 1 DE3 40-44 (18' RT) - DE3 47+31 (10' RT)						40	2007.5 2375 607.5			14	92				2370	0, 5 2, 3, 5 1, 0, 5	DETAIL.  4. GUARDRAIL POSTS SHALL REQUIRE INSTALLATION IN HMA ADJACENT TO CONG BARRIER.	C.
																	5. SEE SPECIAL PROVISION "GUIDE POSTS 6. TYPE B CONNECTION TO CONCRETE BA REQUIRED.	
									- 1								7. GUARDRAIL WILL REQUIRE CONNECTIO EXISTING GUARDRAIL (INSTALLED BY OTH DE3 STA. 22+70.  • THIS ITEM APPEARS ON MULTIPLE QUAN	IERS) AT
	14																TABULATION OR STRUCTURE NOTE SHEET SHEETS SNQT1 - SNQT2 FOR PROJECT TO	TS. SEE
																	.s.	
SHEET TOTAL PROJECT TOTAL	60 60	1380	1725 1725		REGION NO.	-40- -40- STATE	-5400 -5400 FED, AID	PROJ. NO.	6	<del>57_</del>   <i>-</i> 57	<del>-02</del>   <del>-02</del>		51 51	<del>-111440-</del> - <del>111440-</del>	<del>-2970</del> <del>-2070</del>			
DESIGNED BY S. ROBERT ENTERED BY B. CUILLIER CHECKED BY IL. HUCK					10 JOB NU	WASH		(*)				<b>*</b> ×	Washington	State of Transpo	etation		I-90 LUS DAM TO STAMPEDE PASS PHASE D LANES / BUILD WILDLIFE BRIDGES	QS3- 1 SHEET
PROJ. ENGR. J. HEILMAN-SUAREZ REGION ADM. D. WHITEHOUSE DATE DATE		REVISION		BY		015								. J. Hanspo			QUANTITY TABULATION - STAGE 3	91 OF 788 SHEETS

					QUA	NTI	TY T	ABUL	ATIO	ON -	STAC	SE 3E	3					
NOTE: THE FIRST NUMBER OF THE "CODE" BELOW REFERS TO THE SHEET NO. OR THE SHEET REFERENCE NO. SHOWING THE CONSTRUCTION FEATURE.  THE SECOND NUMBER REFERS TO THE CONSTRUCTION FEATURE FOUND ON THAT SHEET.	REMOVING CONC. BARRIER*	REMOVING GUARDRAIL*	REMOVING GUARDRAIL ANCHOR*		BEAM GUARDRAIL TYPE 31 - 8 FT. LONG POST*	WEATHERING ST. BEAM GUARDRAIL TYPE 31*	BEAM GUARDRAIL TYPE 31		BEAM GUARDRAIL TRANSITION SECTION TYPE 21*	BEAM GUARDRAIL TYPE 31 NON-FLARED TERMINAL	BEAM GUARDRAIL ANCHOR TYPE 10		BARRIER GAP•	TEMPORARY CONC. BARRIER*	TEMPORARY IMPACT ATTENUATOR	SEE GENERAL NOTES	GENERAL NOTES:	
CODE   LOCATION → \ UNIT OF MEASURE >  DW3 22+89.46 - ADW3 4537+18.06  DE3 22+69.52 - ADE3 4536+88.06  D3B-1 1 DE3 22+69.52 (14' RT) - DE3 30+70.68 (18' RT)  D3B-1 2 DW23 22+89.46 (13' RT) - ADW3 4537+18.06 (14' RT)		L.F.	EACH		797	L.F.	L.F.		EACH	EACH	1 1 1 1 1 1 1 1 1 1 1 1 1 1 1 1 1 1 1		28	1342 1342	EACH	2, 3, 4	1. TEMPORARY IMPACT ATTENUATOR SHA ONE OF THE FOLLOWING: ABSORB 350, TO CET, OR TRACC AND SHALL INCLUDE SIGN 501.  2. SEE SHEET TDE3 FOR TEMPORARY GLASCREEN DETAIL. SEE SPECIAL PROVISION "CONCRETE BARRIER."  3. SEE SHEET TDE-4 FOR TEMP. CONC. BADETAIL.  4. SEE SPECIAL PROVISION "GUIDE POSTS THIS ITEM APPEARS ON MULTIPLE QUANTABULATION OR STRUCTURE NOTE SHEET SHEETS SNQT1 - SNQT2 FOR PROJECT TO	RITON I W12-  ARE I  ARRIER  S."  SITTY TS. SEE
DESIGNED BY J. BRANCH ENTERED BY M. PANICK CHECKED BY A. SCHMIDTMAN					797 REGION NO. 10 JOB NU	WASH JMBER	FED. AID	PROJ. NO.			1	<b>%</b>	28 Washington Department	1342 State of Transpo	ortation		I-90 ELUS DAM TO STAMPEDE PASS PHASE DD LANES / BUILD WILDLIFE BRIDGES SHEET	
PROJ. ENGR. S. GOLBEK  REGION ADM. D. WHITEHOUSE DATE DATE		REVISION		BY	CONTRA	015 ACT NO.			5							QUANTITY TABULATION - STAGE 3B		OF SHEETS

						QUA	ANTI	TY T	ABUL	ATIO	ON -	STA	GE 31	3					
REFER REFER CONS	RST NUMBER OF THE "CODE" BELOW RS TO THE SHEET NO. OR THE SHEET RENCE NO. SHOWING THE TRUCTION FEATURE.  ECOND NUMBER REFERS TO THE TRUCTION FEATURE FOUND ON THAT	RESETTING IMPACT ATTENUATOR*	TEMPORARY RIGID GUIDE POST (TYPE W)*	TEMPORARY RIGID GUIDE POST (TYPE Y)*		LDS BARRIER DELINEATOR (TYPE W)*	LDS BARRIER DELINEATOR (TYPE Y)*	SNOW POLE		PAINT LINE	PAINTED STOP LINE		TEMPORARY PAVEMENT MARKING-LONG DURATION*	TEMPORARY GLARE SCREEN*			SEE GENERAL NOTES	GENERAL NOTES:	
D3B-1 1	LOCATION Y \ UNIT OF MEASURE > DW3 22+89.46 - ADW3 4537+18.06 DE3 22+69.52 - ADE3 4536+88.06  DE3 22+69.52 (14' RT) - DE3 30+70.68 (18' RT) DW23 22+89.46 (13' RT) - ADW3 4537+18.06 (14' RT)	EACH	EACH	EACH		EACH	46	EACH		L.F.	L.F.		L.F. 4281 4257	1342			2, 3, 4	1. TEMPORARY IMPACT ATTENUATOR SHONE OF THE FOLLOWING: ABSORB 350, TCET, OR TRACC AND SHALL INCLUDE SIGISO1.  2. SEE SHEET TDE3 FOR TEMPORARY GL SCREEN DETAIL. SEE SPECIAL PROVISION "CONCRETE BARRIER."  3. SEE SHEET TDE-4 FOR TEMP. CONC. BDETAIL.  4. SEE SPECIAL PROVISION "GUIDE POST: THIS ITEM APPEARS ON MULTIPLE QUAITABULATION OR STRUCTURE NOTE SHEET SHEETS SNQT1 - SNQT2 FOR PROJECT TO	ARE ARRIER S." NTITY TS. SEE
	SHEET TOTAL		İ			REGION NO.	46 STATE	     FED. AID	PROJ. NO.			İ	8538	1342			1		
ENTERE CHECKI PROJ. E	JED BY J. BRANCH ED BY M. PANICK ED BY A. SCHMIDTMAN ENGR. S. GOLBEK A ADM. D. WHITEHOUSE DATE DATE		REVISION		BY	14Y	WASH UMBER '015 ACT NO.			1				Vashington Jepartment	State of Transpo	ortation	2A - AD	I-90 LUS DAM TO STAMPEDE PASS PHASE D LANES / BUILD WILDLIFE BRIDGES  UANTITY TABULATION - STAGE 3B	QS3B-1

