



Contract Number 9419	Contract Title Lacamas Creek Bridge Replacement	Federal Aid Number #STBG-0506(004)
Change Order Number 001	Change Description Differing Site Conditions	Date Jul 8, 2020
Region Southwest Region	Project Engineer Colin Newell	Phone Number 360-740-8600
Prime Contractor / Design-Builder Farline Bridge, Incorporated		

- Ordered by Engineer under the terms of Section 1-04.4 of the Standard Specifications or the RFP
- Change proposed by Contractor / Design-Builder

Evolution & Description Of Change

The Contractor encountered differing site conditions during construction of the 6 foot diameter shafts at piers 1 and 2 of Bridge NO. 506/106, this encounter resulted in revisions to plan sheets BR5, BR6, and BR35 and this change order. Highly Weathered Sandstone at approximately the 40 foot elevation at pier 1 and 30 foot elevation at pier 2 was found to be described as Differing Site Conditions, defined by Standard Specification 1-04.7. WSDOT recognizes the differing site condition as a preexisting subsurface condition encountered on the project, differing materially from what was indicated in the contract.

This change order compensates the Contractor for the added work resulting from a differing site condition encountered while installing shafts for Bridge NO. 506/106. This work is described below.

This change order is to compensate the Contractor for costs borne by differing site conditions described as follows: Constructing 5.5 ft. diam. shaft, force account for differing site condition additional cost, additional erosion control and water pollution prevention, WSDOT reimbursement of salvaged steel from 6 ft. diam. shafts and costs associated with stranded direct costs of labor, equipment and materials.

Constructing 5.5 ft. diam. shaft includes materials, equipment, mobilization and demobilization of equipment, labor for building beds required for tying rebar cages, drilling and pouring shafts at piers, breaking down and loading materials used for constructing tying beds, Engineering services for shaft cage construction, rock to backfill subgrade at piers, dump fees for excavated shaft materials and for dewatering at piers.

Force account for differing site condition additional cost includes labor, equipment and materials, utilized by the subcontractor for slower production rates, The prime is compensated for assisting the sub-contractor during this time, rental of falsework, baker tanks and equipment identified on this change orders justification of cost sheets.

Additional erosion control and water pollution prevention needed during the period of time the Contractor was required to perform environmental work for permit compliance, includes materials, equipment and labor used by the prime for compliance of permits.

This change order creates the following new item:

“Cost via Differing Site Conditions”



Contract Number 9419	Contract Title Lacamas Creek Bridge Replacement	Change Order Number 001
-------------------------	--	----------------------------

Basis of Cost & Justification:

This change order is to provide lump sum payment to the Contractor for added work to this contract. The independent Engineers Estimate of \$673,839.00 conducted by WSDOT staff supports the agreed upon price of \$673,839.00 paid in this change order. The Contractor is entitled to the additional compensation, as this is added work to the contract per Standard Specification 1-04.4.

The net cost to the contract is estimated at \$673,839.00.

Please see attached cost justification.

Contract Time:

This change order adds an additional 15 working days to the contract time. Of the additional working days 12 are for time spent constructing 5.5 ft. diam. shaft and 3 days for force account - differing site condition additional cost, the added work was a continuation of critical path work. The Contractors request for additional working days was evaluated in accordance with section 1-08.8 of the Standard Specifications.

Prior Approvals:

Colin Newell, P.E., Chehalis Area Engineer, gave his approval for this change order on February 25, 2020.
Chris Tams, P.E., WSDOT Southwest Region Construction Engineer, gave approval on February 25, 2020.
Neal Uhlmeyer, P.E., WSDOT HQ Construction Engineer, gave approval on February 25, 2020.

List Attachments:

P.E. approval, Region Construction Engineer approval, Construction Engineer approval.
Revised and added plan sheets.
Cost justification with Vertex Calendar of work items and letter describing cost by Wes Anderson.
Change Order Check List.

Distribution: Copy of Change Record & Change Order w/Backup - Project Engineer
 Copy of ONLY Change Order - Prime Contractor / Design-Builder
 Copy of Change Record & Change Order w/Backup - Region Construction Office
 Electronic Copy & Original of Change Record & Change Order w/Backup - State Construction Office



WASHINGTON STATE
DEPARTMENT OF TRANSPORTATION
CHANGE ORDER

DATE: 06/24/20
PAGE 1 of 6

CONTRACT NO: 009419 FEDERAL AID NO: STBG-0506(004)
CONTRACT TITLE: SR 506, LACAMAS CREEK BRIDGE REPLACEMENT
CHANGE ORDER NO: 1 DIFFERING SITE CONDITIONS




PRIME CONTRACTOR: SW0251037 FARLINE BRIDGE, INCORPORATED
1455 MILLER DR
97383-9431
STAYTON OR 97383-0149

() Ordered by Engineer under the terms of Section 1-04.4 of the Standard Specifications
(X) Change proposed by Contractor

ENDORSED BY: Farline Bridge Inc.  <small>Joey Walczak (Jul 2, 2020 14:33 PDT)</small>	SURETY CONSENT: Liberty Mutual Insurance Company  <small>Ty Moffett (Jul 2, 2020 14:35 PDT)</small>
CONTRACTOR SIGNATURE Jul 2, 2020 <hr/> DATE	ATTORNEY IN FACT Jul 2, 2020 <hr/> DATE

ORIGINAL CONTRACT AMOUNT: 3,238,905.33
CURRENT CONTRACT AMOUNT: 3,582,384.35
ESTIMATED NET CHANGE THIS ORDER: 673,839.00
ESTIMATED CONTRACT TOTAL AFTER CHANGE: 4,256,223.35

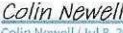Signature Required: (X) Project Engineer (X) State Construction Engineer
(X) Regional Administrator () Other Agency

 <small>Colin Newell (Jul 8, 2020 09:44 PDT)</small>	
PROJECT ENGINEER SIGNATURE Jul 8, 2020 <hr/> DATE	STATE CONSTRUCTION ENGINEER SIGNATURE Jul 9, 2020 <hr/> DATE
 <small>Chris Tams (Jul 9, 2020 07:04 PDT)</small>	OTHER APPROVAL WHEN REQUIRED
REGIONAL ADMINISTRATOR SIGNATURE Carley Francis Jul 9, 2020 <hr/> DATE	SIGNATURE _____ DATE _____ REPRESENTING _____

CONTRACT NO: 009419

CHANGE ORDER NO: 1

All work, materials, and measurements to be in accordance with the provisions of the Standard Specifications and Special Provisions for the type of construction involved.

This contract is revised as follows:

DESCRIPTION OF WORK

This change order revises Plan Sheets BR5, BR6, and BR35 as shown on sheets 4, 5 and 6 of this change order and compensates the Contractor for the Differing Site Condition (Changed Conditions) encountered during construction of the 6 foot diameter shafts at piers 1 and 2 of Bridge NO. 506/106.

This change order is to compensate the Contractor for costs borne by differing site conditions described as follows: Constructing 5.5 ft. diam. shaft, force account for differing site condition additional cost, additional erosion control and water pollution prevention, WSDOT reimbursement of salvaged steel from 6 ft. diam. shafts and costs associated with stranded direct costs of labor, equipment and materials. The item "Cost via Differing Site Conditions" is shown on sheet 3 of this change order.

This work shall be in accordance with all contract requirements as follows: Plans, Revised Plans, and Special Provisions associated with this Change Order.

This change order creates the following new item:

"Cost via Differing Site Conditions"

MATERIALS

The materials for the item "Cost via Differing Site Conditions" shall conform to the contract requirements, Plans, Revised Plans, and Special Provisions associated with this Change Order.

CONSTRUCTION REQUIREMENTS

Construction requirements for the item "Cost via Differing Site Conditions" pertaining to constructing 5.5 ft. diam. shaft shall conform to the requirements of revised plans shown on sheets BR5, BR6 and BR35 of this change order, pertaining to force account for differing site condition additional cost shall be in accordance with Section 1-09.6, salvaged steel shall be as follows: Unused reinforcing bars and casing from Bid Item No. 20, "Constructing 6 Ft. Diam. Shaft", shall be salvaged.

PAYMENT

The item "Cost via Differing Site Conditions" will be paid at the agreed lump sum amount of \$673,839.00.

The Contractor, Farline Bridge, LLC, by the signing of this change order agrees and certifies that:

Upon payment of this change order in the amount of \$673,839.00, total compensation for any and all work performed as a result of encountering the differing site condition (DSC) and subsequent work from the re-design of the shafts and bridge approach backfill have been satisfied in full and the State of Washington is released and discharged from any extra compensation or entitlements in any manner arising out of Contract No. 9419 regarding the differing site condition (DSC) for the 6 foot diameter shafts.

CONTRACT TIME

This change order adds 15 working days to the contract.

WASHINGTON STATE
 DEPARTMENT OF TRANSPORTATION
 CHANGE ORDER



DATE:06/24/20
 PAGE 3 of 6

CONTRACT NO:009419				CHANGE ORDER NO: 1		
ITEM NO	GROUP NO	STD ITEM	UNIT OF MEASURE	UNIT PRICE	EST QTY CHANGE	EST AMT CHANGE

ITEM DESCRIPTION:	COST VIA DIFFERING SITE CONDITIONS					
1015 01	L.S.			0.00	0.00	673,839.00


AMOUNT TOTAL

 673,839.00
 =====

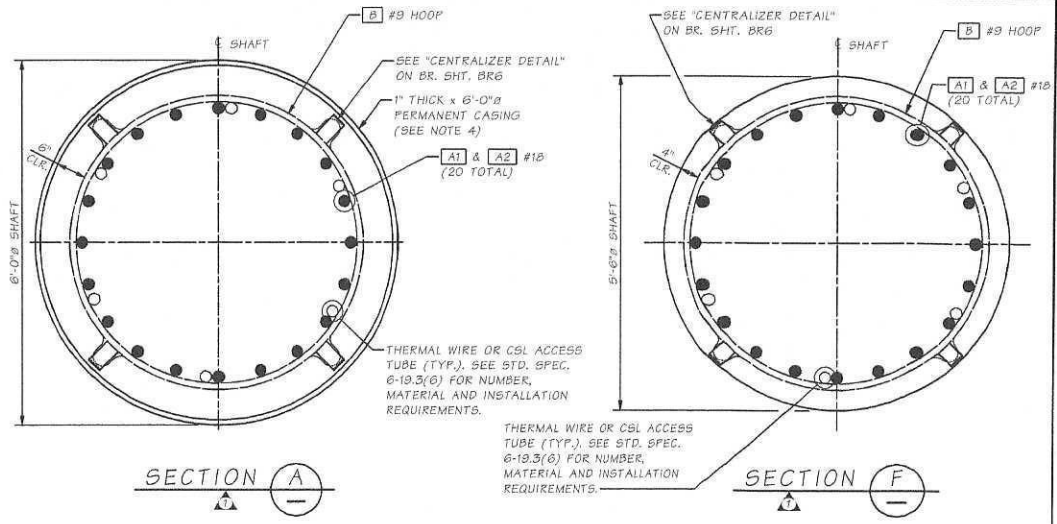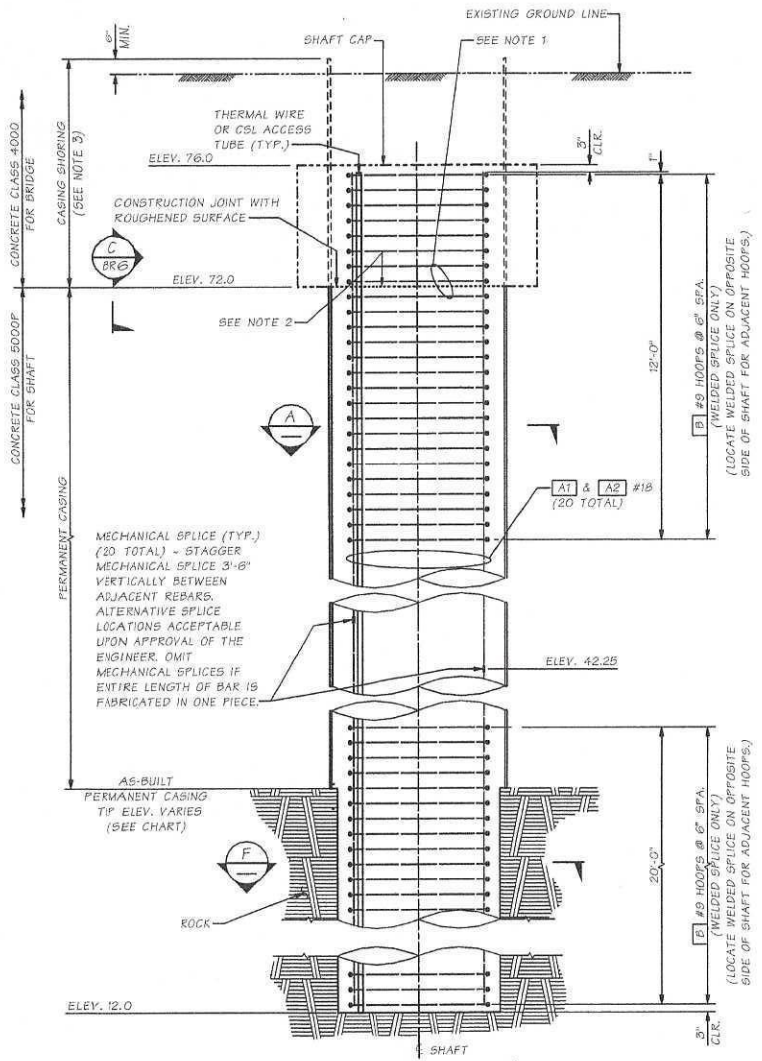

AS-BUILT PERMANENT CASING TIP ELEVATION

SHAFT	TIP ELEV.
1A	27.61
1B	29.30
1C	26.70
2A	23.05
2B	24.44
2C	25.03

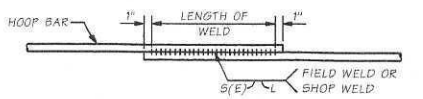

WELDED LAP SPlice DETAIL
WELDING SHALL MEET THE REQUIREMENTS OF STD. SPEC. 6-02.3(2A) FOR WELD DIMENSIONS, SEE TABLE BELOW.

DEFORMED BAR	WELD DIMENSIONS		
	S	E	LENGTH (L)
HOOPS	#9	3/4"	8"

- NOTES:**
- ADJUST HOOP SPACING TO PROVIDE CLEARANCE FOR SHAFT CAP REINFORCEMENT.
 - REMOVE SEDIMENT, LAITENCE & WEAK CONCRETE FROM TOP OF SHAFT TO SOUND CONCRETE PRIOR TO SETTING SHAFT CAP REINFORCEMENT.
 - CASING SHORING MAY BE DELETED PROVIDED THAT THE CONTRACTOR SHORES AND EXCAVATES FOR THE SHAFT CAP PRIOR TO THE SHAFT EXCAVATION.
 - PERMANENT CASING SHALL CONFORM TO ONE OF THE FOLLOWING:
 - API 5L GRADE X52 FOR LONGITUDINAL SEAM WELDED OR HELICAL (SPIRAL) SEAM SUBMERGED-ARC WELDED CASING.
 - ASTM A252 GRADE 3 FOR LONGITUDINAL SEAM WELDED OR HELICAL (SPIRAL) SEAM SUBMERGED-ARC WELDED CASING. MINIMUM YIELD STRENGTH SHALL BE 50 KSI.
 - ASTM A572 GRADE 50 OR ASTM A500 FOR LONGITUDINAL SEAM WELDED CASING.

Bridge Design Inrg.	Khalighi, B	M:\X-Traffic\BR506-106_LACAMAS CREEK_BR REPLACEMENT_SWR\window\Files\CO1-SHAFTDTLS1.wnd	RECORD NO.	STATE	FED. AID PROJ. NO.	SHEET NO.	TOTAL SHEETS
Supervisor	Atgirth, BS		ID	WASH4			
Designed By	Ferly, C	12/18	JOB NUMBER	100-217	CONTRACT NO.		
Checked By	SawaHata, D	02/19	DATE	REVISION	BY	APPD.	
Detailed By	Bontemps, W	02/18					
Bridge Projects Engr.							
Prelim. Plan By		10/11/19	REVISED SHEET				
Architect/Specalist							

BRIDGE AND STRUCTURES OFFICE


SR 506
LACAMAS CREEK BRIDGE REPLACEMENT
LACAMAS CREEK BRIDGE NO. 506/106
SHAFT
DETAILS 1 OF 2

SHEET NO. BR5


SHEET 31

OF 67

DATE

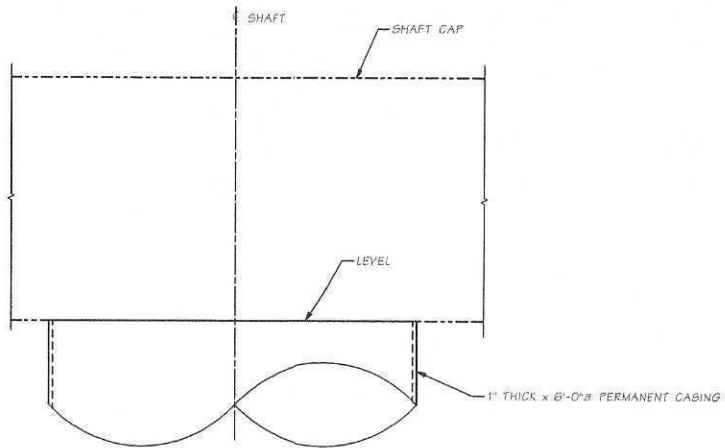

SECTION C
REINFORCING BARS NOT SHOWN BR5

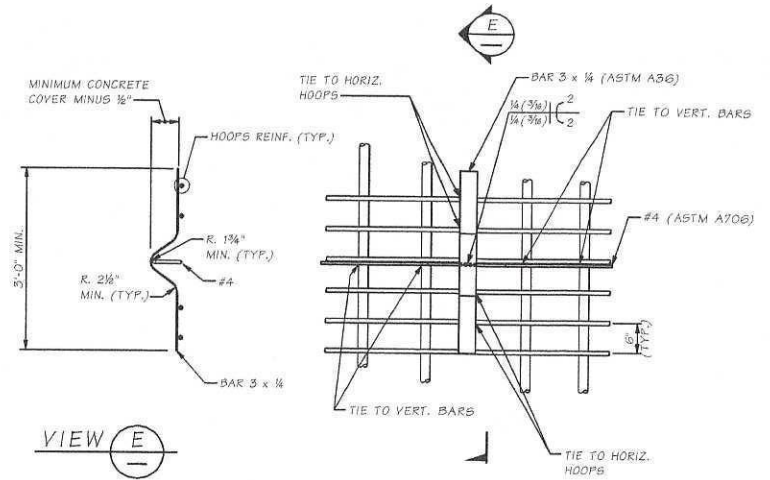

CENTRALIZER DETAIL

CENTRALIZER NOTES:

1. EACH LEG SHALL BE TIED TO TWO VERTICAL BARS AND TWO HOOPS.
2. SEE STD. SPEC. 6-19.3(B) FOR SPACING REQUIREMENTS.

SR 506 FILE NO. SHEET 1066

Bridge Design Drgr.	Khalafchi, B	M:\X-Team\BR506-106_LACAMAS CREEK BR REPLACEMENT_swr>window Files\CO1-SHAFTDTLS2.wnd	REVISION NO.	STATE	FED. AID PROJ. NO.	APP. NO.	TOTAL SHEETS
Supervisor	Aldrich, BS			10	WASH.		
Designed By	Feeley, C	12/18					
Checked By	Sawahata, D	02/19					
Detailed By	Bontemps, W	02/18					
Bridge Projects Engr.							
Prelim. Plan By		10/1/19	REVISIED SHEET	ZCF	BISA		
Architect/Specalist			REVISION				
		DATE	REVISION	BY	APPD	CONTRACT NO.	



Oct 11 2019 1:06 PM

BRIDGE AND STRUCTURES OFFICE



Oct 11 2019 1:35 PM



SR 506
LACAMAS CREEK BRIDGE REPLACEMENT
LACAMAS CREEK BRIDGE NO. 506/106

SHAFT
DETAILS 2 OF 2

BRIDGE SHEET NO.
BR5
SHEET 32 OF 67

MARK NO.	LOCATION	SIZE	HP	NO. END	DISTR.	REIN. TYPE	LUMP QTY	DIMENSIONS (Out to Out)											LENGTH	WEIGHT
								U	W	X	Y	Z	θ ₁	θ ₂	θ ₃	θ ₄	θ ₅	θ ₆		
<p>PIER 1 SHAF CAP</p> <p>100 Top Longitudinal 8 9 50 43 8.0 1049</p> <p>101 Bottom Longitudinal 11 9 30 43 8.0 2088</p> <p>102 Side Longitudinal 7 7 16 43 8.0 1428</p> <p>103 Stirrup 7 7 27 15 42 1207</p> <p>104 Stirrup 7 7 36 17 43 1207</p> <p>105 Tie 7 7 36 17 43 1056</p> <p>106 End Tie 7 7 14 43 8.0 107</p> <p>107 End Tie 6 6 14 43 8.0 119</p> <p>PIER 1 ABUTMENT WALL</p> <p>108 Far Face Vertical 7 7 89 54 1824</p> <p>109 Near Face Vertical 7 7 45 54 922</p> <p>PIER 1 RT WINGWALL</p> <p>110 Horizontal 10 15 17 80 707</p> <p>111 Wall Tie 4 4 32 58 79</p> <p>112 Top Wall Tie 4 4 22 74 545</p> <p>113 Girder Stop Tie 4 4 22 74 545</p> <p>114 Girder Stop Tie 4 4 13 74 117</p> <p>115 Girder Stop Tie - RT 4 4 3 74 69</p> <p>115 Girder Stop Tie - LT 4 4 3 74 15</p> <p>PIER 1 LT WINGWALL</p> <p>120 Far Face Vertical 7 7 10 54 495</p> <p>120 Far Face Vertical 7 7 2 56 79</p> <p>121 Far Face Vertical 7 7 39 50 624</p> <p>122 Near Face Vertical 5 5 6 54 170</p> <p>122 Near Face Vertical 5 5 20 50 40</p> <p>123 Near Face Vertical 5 5 20 50 34</p> <p>124 Near Face Horizontal 5 5 2 80 52</p> <p>124 Near Face Horizontal 5 5 14 80 181</p> <p>125 Far Face Horizontal 7 7 4 80 203</p> <p>125 Far Face Horizontal 7 7 26 80 552</p> <p>126 Bottom Edge 7 7 2 80 93</p> <p>127 Top Edge 4 4 2 74 7</p> <p>PIER 1 RT WINGWALL</p> <p>120 Far Face Vertical 7 7 7 54 244</p> <p>120 Far Face Vertical 7 7 6 54 203</p> <p>121 Far Face Vertical 7 7 39 50 370</p> <p>122 Near Face Vertical 5 5 4 54 135</p> <p>122 Near Face Vertical 5 5 3 54 70</p> <p>123 Near Face Vertical 5 5 19 50 50</p> <p>124 Near Face Horizontal 5 5 2 80 49</p> <p>124 Near Face Horizontal 5 5 11 80 177</p> <p>125 Far Face Horizontal 7 7 4 80 196</p> <p>125 Far Face Horizontal 7 7 20 80 639</p> <p>126 Bottom Edge 7 7 2 80 89</p> <p>127 Top Edge 4 4 2 74 7</p> <p>PIER 2 SHAF CAP</p> <p>200 Top Longitudinal 8 9 50 40 8.0 877</p> <p>201 Bottom Longitudinal 11 9 30 40 8.0 1345</p> <p>202 Side Longitudinal 7 7 16 40 8.0 1330</p> <p>203 Stirrup 7 7 27 15 40 1044</p> <p>204 Stirrup 7 7 36 17 40 710</p> <p>205 Tie 7 7 36 17 40 810</p> <p>206 End Tie 7 7 14 40 8.0 107</p> <p>207 End Tie 6 6 14 40 8.0 110</p> <p>PIER 2 ABUTMENT WALL</p> <p>208 Far Face Vertical 7 7 84 54 1714</p> <p>209 Near Face Vertical 7 7 43 54 877</p> <p>PIER 2 LT WINGWALL</p> <p>210 Horizontal 10 15 17 80 667</p> <p>211 Wall Tie 4 4 30 58 76</p> <p>212 Top Wall Tie 4 4 22 74 512</p> <p>213 Girder Stop Tie 4 4 22 74 512</p> <p>214 Girder Stop Tie 4 4 13 74 117</p> <p>215 Girder Stop Tie - RT 4 4 3 74 69</p> <p>215 Girder Stop Tie - LT 4 4 3 74 15</p> <p>PIER 2 RT WINGWALL</p> <p>220 Far Face Vertical 7 7 7 54 244</p> <p>220 Far Face Vertical 7 7 6 54 203</p> <p>221 Far Face Vertical 7 7 39 50 370</p> <p>222 Near Face Vertical 5 5 4 54 135</p> <p>222 Near Face Vertical 5 5 20 50 40</p> <p>223 Near Face Vertical 5 5 20 50 34</p> <p>224 Near Face Horizontal 5 5 2 80 52</p> <p>224 Near Face Horizontal 5 5 11 80 177</p> <p>225 Far Face Horizontal 7 7 4 80 196</p> <p>225 Far Face Horizontal 7 7 20 80 639</p> <p>226 Bottom Edge 7 7 2 80 89</p> <p>227 Top Edge 4 4 2 74 7</p> <p>PIER 2 RT WINGWALL</p> <p>220 Far Face Vertical 7 7 9 54 313</p> <p>220 Far Face Vertical 7 7 39 50 624</p> <p>222 Near Face Vertical 5 5 6 54 170</p> <p>222 Near Face Vertical 5 5 20 50 40</p> <p>223 Near Face Vertical 5 5 20 50 34</p> <p>224 Near Face Horizontal 5 5 2 80 52</p> <p>224 Near Face Horizontal 5 5 11 80 177</p> <p>225 Far Face Horizontal 7 7 4 80 196</p> <p>225 Far Face Horizontal 7 7 20 80 639</p> <p>226 Bottom Edge 7 7 2 80 93</p> <p>227 Top Edge 4 4 2 74 7</p> <p>END DIAPHRAGMS</p> <p>320 Deck Transverse 6 6 4 32 337</p> <p>321 Stirrup 4 4 118 54 817</p> <p>322 Stirrup 4 4 59 74 420</p> <p>323 Transverse Seat Tie 4 4 2 74 34</p> <p>324 Diaphrag Transverse 4 4 40 50 588</p> <p>325 Diaphrag Transverse - Bot. 6 6 4 40 211</p> <p>HNT DIAPHRAGMS</p> <p>330 Deck Transverse 6 6 6 32 443</p> <p>331 Bottom Transverse 6 6 128 50 845</p> <p>332 Middle Transverse 6 6 128 50 845</p> <p>333 Top Transverse 6 6 128 50 845</p> <p>334 Stirrup 6 6 4 32 337</p> <p>335 Tie 6 6 4 32 337</p> <p>DECK - TOP MAT</p> <p>300 Top Mat - West Splay 5 5 2 51 45</p> <p>300 Top Mat - West Splay 5 5 18 50 122</p> <p>300 Top Mat - West Splay 5 5 11 50 77</p> <p>300 Top Mat - West Splay 5 5 13 50 111</p> <p>300 Top Mat - West Splay 5 5 13 50 111</p> <p>300 Top Mat - West Splay 5 5 13 50 111</p> <p>302 Top Mat - Transverse 5 5 319 51 2237</p> <p>303 Top Mat - Transverse 5 5 319 51 2237</p> <p>304 Top Mat - East Skew 5 5 20 51 125</p> <p>305 Top Mat - East Splay 4 4 5 51 47</p> <p>306 Top Mat - East Splay 4 4 5 51 47</p> <p>306 Top Mat - Longitudinal bar 4 4 33 89 102</p> <p>307 Top Mat - Long. Bar - Girder 5 5 10 89 187</p> <p>308 Top Mat - Barrier Bar 4 4 26 51 6</p> <p>DECK - BOTTOM MAT</p> <p>310 Bottom Mat - West Splay 6 6 14 50 386</p> <p>312 Bottom Mat - West Skew 6 6 7 50 20</p> <p>312 Bottom Mat - Transverse Bar 6 6 222 50 1623</p> <p>313 Bottom Mat - Transverse Bar 6 6 222 50 1623</p> <p>314 Bottom Mat - East Skew 6 6 7 50 20</p> <p>315 Bottom Mat - East Splay 6 6 14 50 386</p> <p>316 Bottom Longitudinal 11 9 45 89 8494</p> <p>317 Bottom Long. Girder 6 6 10 89 187</p> <p>WICK - STIRRUPS</p> <p>318 Narrow stirrup 3 3 1150 77 37</p> <p>319 Wide stirrup 3 3 1150 77 63</p> <p>BARRIER CONNECTION</p> <p>81 Barrier connection 5 5 490 59 39</p> <p>82 Barrier connection shaft 1 1 0 0 1 1 1 1 1 1 0 0 0 0 0 0 0 0</p> <p>81 Shaft Hoops 4 4 10 0 0 0 0 0 0 0 0 0 0 0 0 0 0</p> <p>81 Shaft Longitudinal 18 18 396 56 15</p> <p>82 Shaft Longitudinal 18 18 396 56 15</p>																				

